


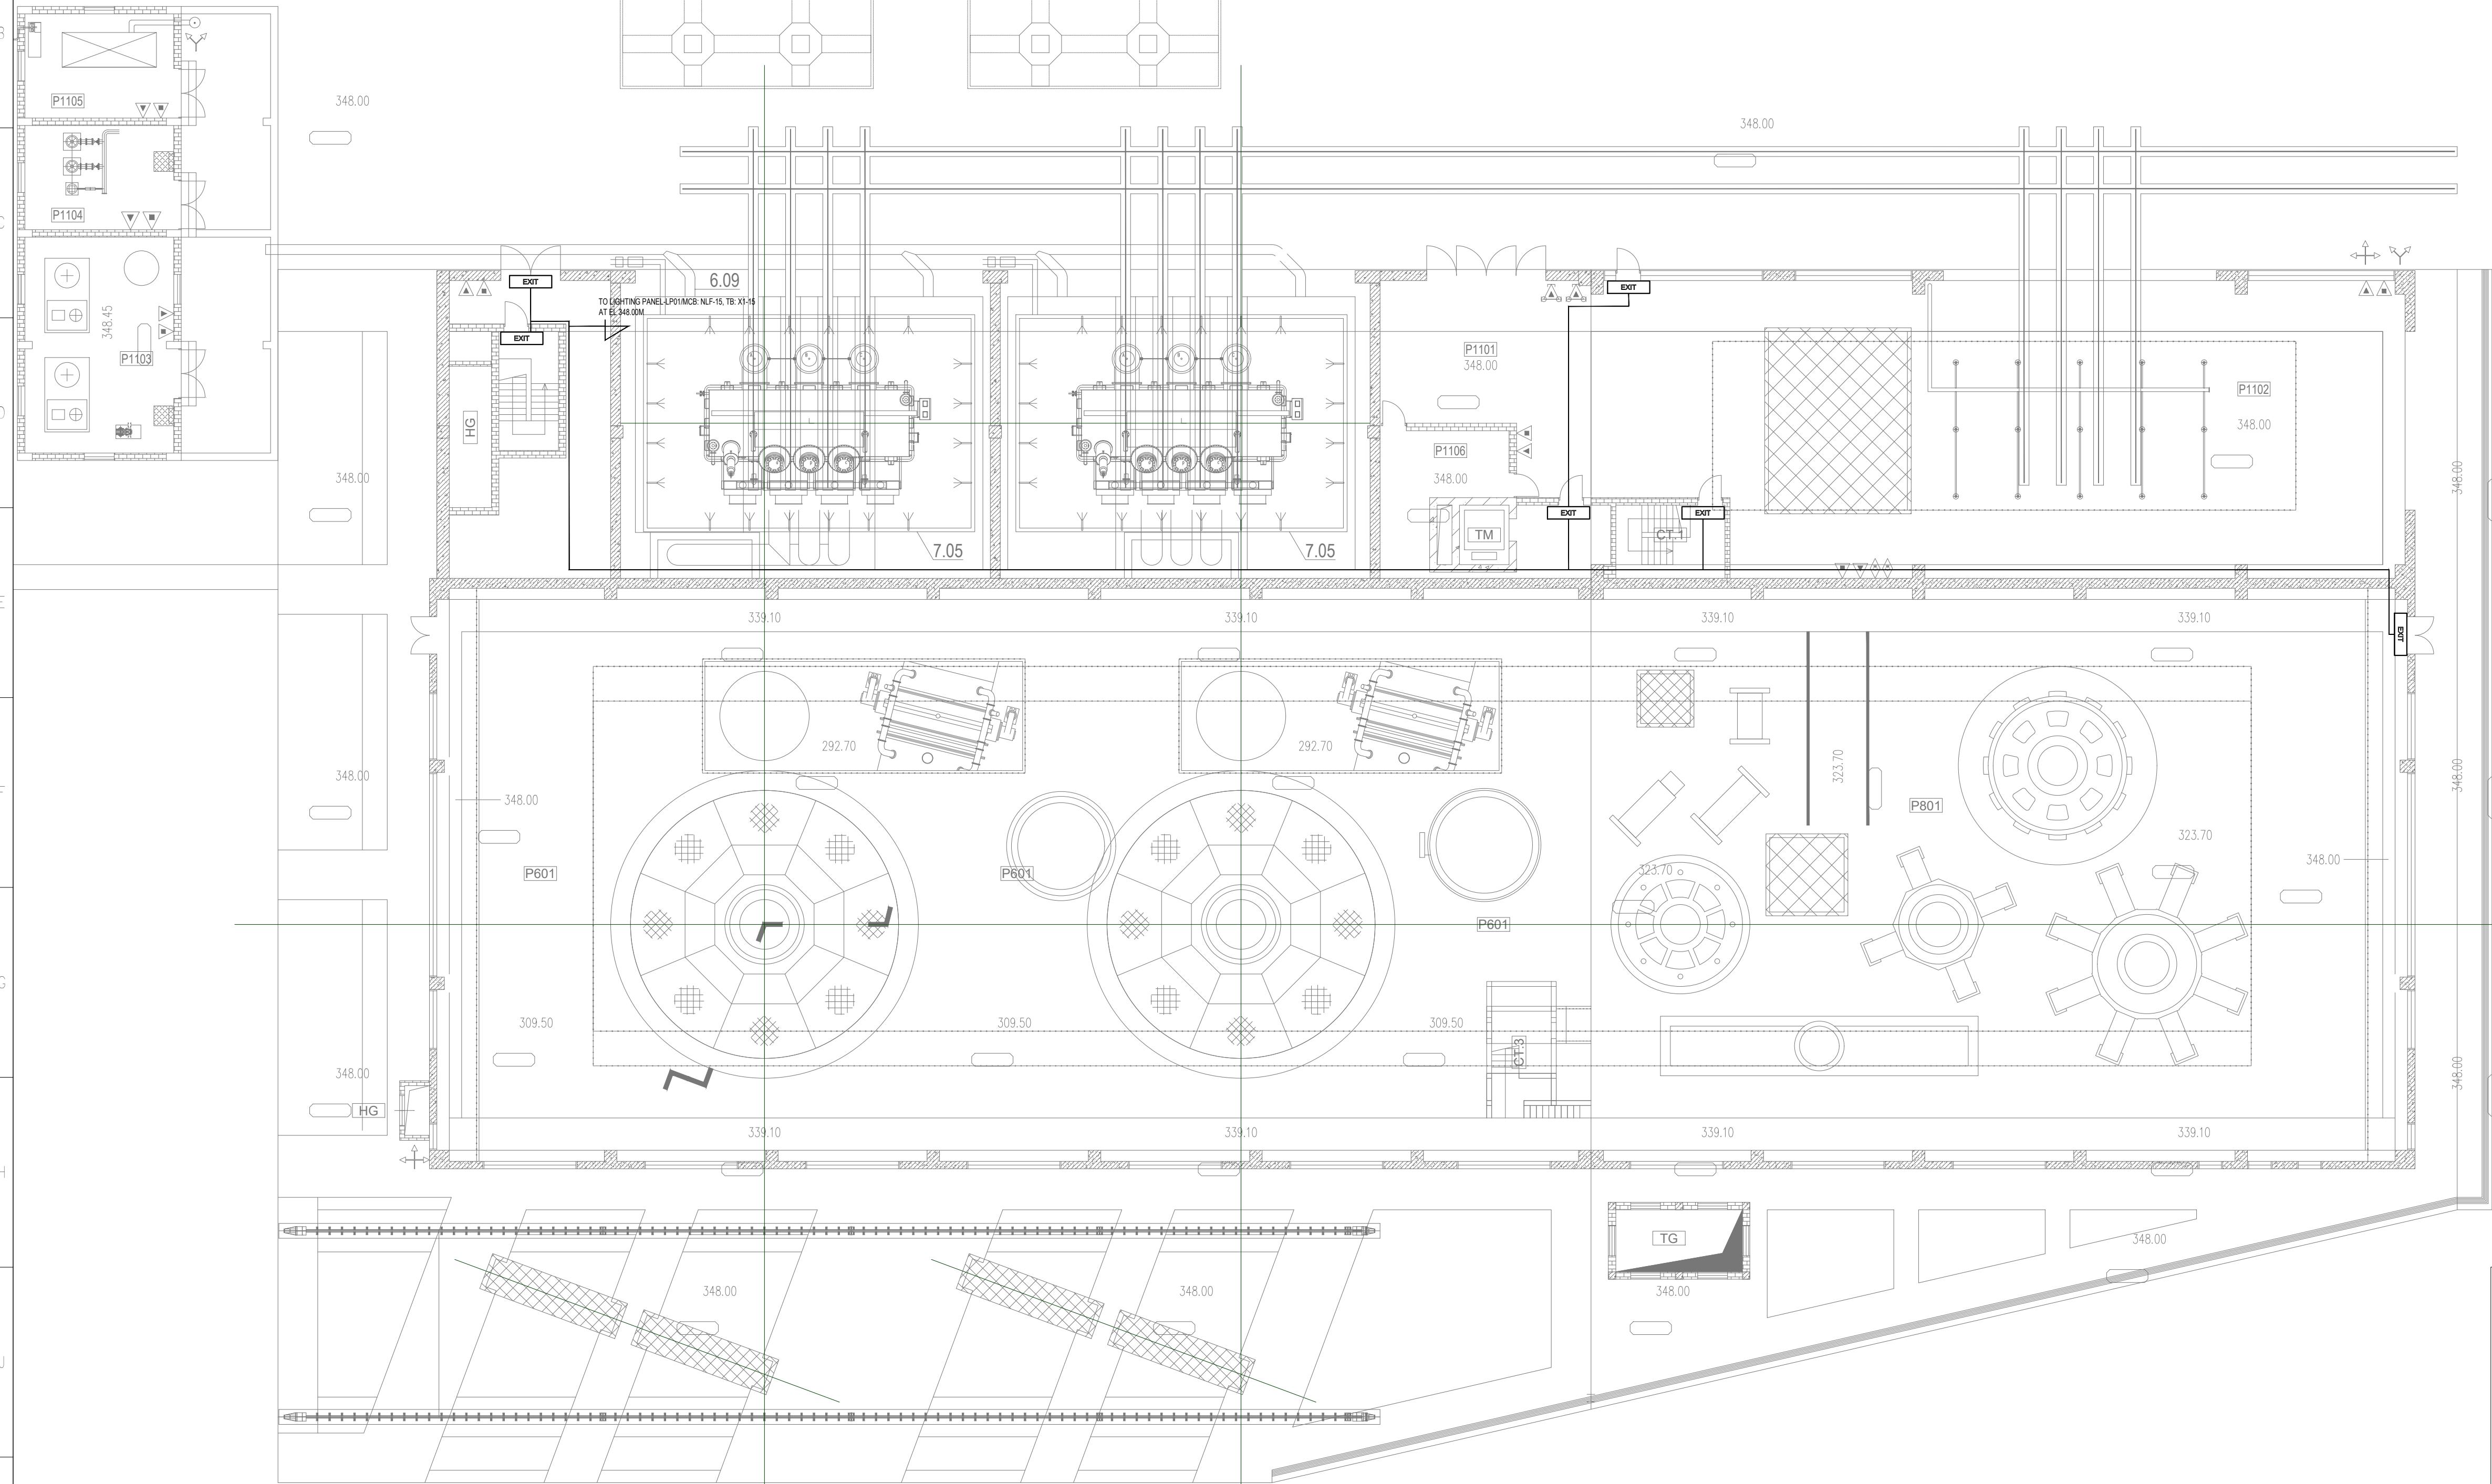

EXIT LAMP
EL. 348.00 PLAN LAYOUT

LEGEND:-

NO.	SYMBOL	DESCRIPTION	Q'ty	REMARK
01.		POWER SUPPLY FOR LIGHTING SYSTEM	-	BY AH
02.		FIRE EXIT TO UPSTAIRS	-	
03.		FIRE EXIT TO RIGHT	-	
04.		FIRE EXIT TO LEFT	-	
05.		FIRE EXIT	6	



PURCHASER : **POWER PROJECTS MANAGEMENT
BOARD NO. 2 - BRANCH OF
VIETNAM ELECTRICITY EVNPMB2)**



ANDRITZ HYDRO GmbH & 3 C INCORPORATION

PROJECT :

**ITALY HYDRO POWER PLANT EXTENSION
(2X180MW)
PACKAGE- NO.40 TB-01 (VIETNAM)**

AS-BUILT DRAWINGS					
B	REVISED AS PER CLIENT COMMENTS VIDE LETTER NO. 0709	22.Jan.24	N.V.T	D.V.L	LD
A	INITIAL SUBMISSION	27.Nov.23	N.V.T	D.V.L	LD

Index	Änderung Modification	Datum Date	Bearbeitet Prepared by	Geprüft Checked	Geprüft Checked	Genehmigt Approved
Stückliste/Partlist	Abmess./Dimension	Gruppe/Group	WA Nr.	Klassen Nr.	Type	Maßstab/Scale

**LAYOUT DRAWING FIRE DETECTION &
ALARM SYSTEM**

HAY	Datum/Date	Name	Kunde/Client	POWER PROJECTS MANAGEMENT BOARD NO. 2 (PMB2)	Schutzvermerk
Gez./Drawn	24.12.2022	NK	Anlage/Plant	ITALY HYDRO POWER PLANT EXTENSION	ISO 18016 beachten
Gepr./Checked	24.12.2022	JCP	Projekt/Project	N° 24/IALYMR/2022/HB-A02-AH-3C	Refer to protection notice ISO 18016
Gepr./Checked	24.12.2022	BRS	Vertr./Contract	N° 24/IALYMR/2022/HB-A02-AH-3C	Ähnl./Similar
Genehm./Appr.	24.12.2022	JCP	File		Ers./Replace

ANDRITZ

Interne N°/Internal N°

XXXX

Zeichnungs N°/Drawing N°

ITALY-P40-AH-300-LAY-SGA-DG-1931-DI


Index
von/of

BL./Sht. 22
31

This drawing is the property of
ANDRITZ HYDRO GmbH
Elektronengasse 20 120 Vienna, Austria

Refer the protection notice ISO 16016

CAD: AUSTO1

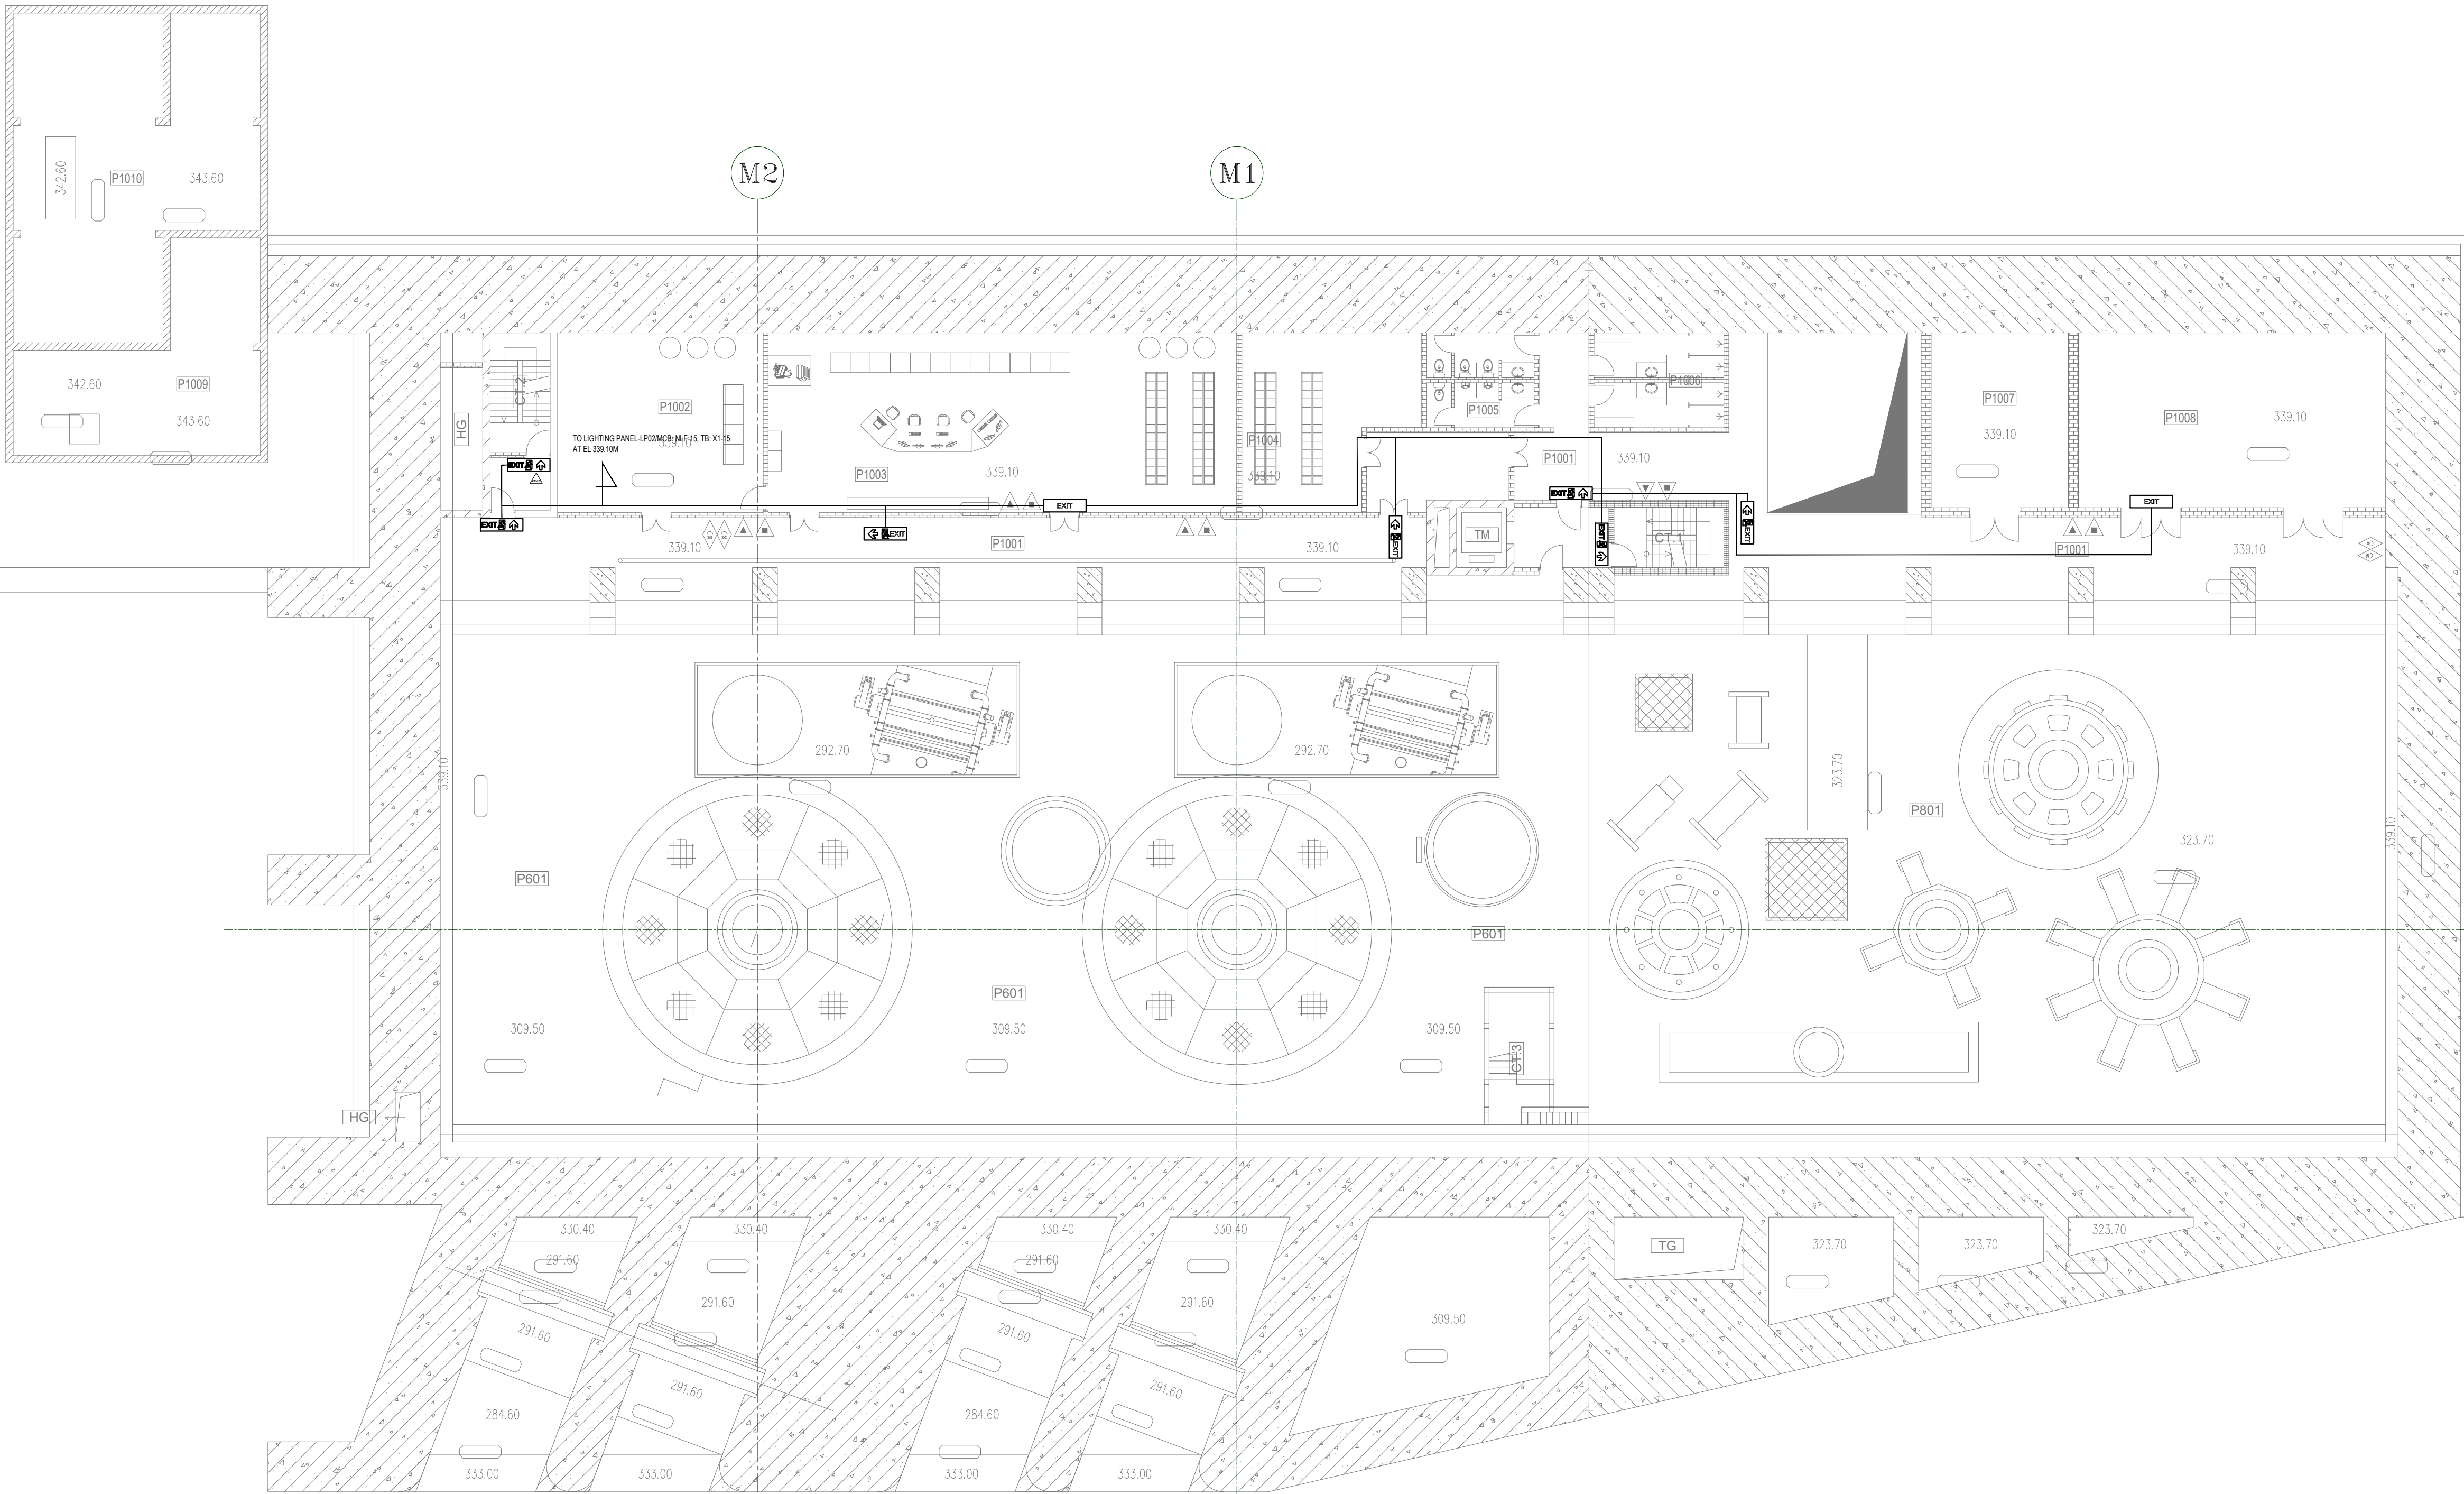

EXIT LAMP
EL. 339.10 PLAN LAYOUT

LEGEND:—

NO.	SYMBOL	DESCRIPTION	Q'ty	REMARK
01.		POWER SUPPLY FOR LIGHTING SYSTEM	—	BY AH
02.		FIRE EXIT TO UPSTAIRS	4	
03.		FIRE EXIT TO RIGHT	3	
04.		FIRE EXIT TO LEFT	—	
05.		FIRE EXIT	2	

REV B



PURCHASER : **POWER PROJECTS MANAGEMENT
BOARD NO. 2 - BRANCH OF
VIETNAM ELECTRICITY EVNPMB2)**



ANDRITZ HYDRO GmbH & 3 C INCORPORATION

PROJECT :

**ITALY HYDRO POWER PLANT EXTENSION
(2X180MW)
PACKAGE- NO.40 TB-01 (VIETNAM)**

AS-BUILT DRAWINGS					
B REVISED AS PER CLIENT COMMENTS VIDE LETTER NO. 0709	22.Jan.24	N.V.T	D.V.L	LD	
A INITIAL SUBMISSION	27.Nov.23	N.V.T	D.V.L	LD	

Index	Änderung Modification	Datum Date	Bearbeitet Prepared by	Geprüft Checked	Geprüft Checked	Genehmigt Approved
-------	--------------------------	---------------	---------------------------	--------------------	--------------------	-----------------------

Stückliste/Partlist	WA Nr.
Abmess./Dimension	Klassen Nr.
Gruppe/Group	Type
	Maßstab/Scale

**LAYOUT DRAWING FIRE DETECTION &
ALARM SYSTEM**

HAY	Datum/Date	Name	Kunde/Client	POWER PROJECTS MANAGEMENT BOARD NO. 2 (DPMB2)	Schutzvermerk
Gez./Drawn	24.12.2022	NK	Anlage/Plant	ITALY HYDRO POWER PLANT EXTENSION	ISO 16016 beachten
Gepr./Checked	24.12.2022	JCP	Projekt/Project	N° 24/IALYMR/2022/H0-A02-AH-3C	Refer to protection notice ISO 16016
Gepr./Checked	24.12.2022	BRS	Vertr./Contract	N° 24/IALYMR/2022/H0-A02-AH-3C	Ähnl./Similar
Genehm./Appr.	24.12.2022	JCP	File		Ers./Replace

ANDRITZ

XXXX


Zeichnungs N°/Drawing N°
ITALY-P40-AH-300-LAY-SGA-DG-1931-DI

Index
Bl./Sht. 23
von/of 31

This drawing is the property of
ANDRITZ HYDRO GmbH
Elektronengasse 20 120 Vienna, Austria

Refer the protection notice ISO 16016

CAD: AUSTO1

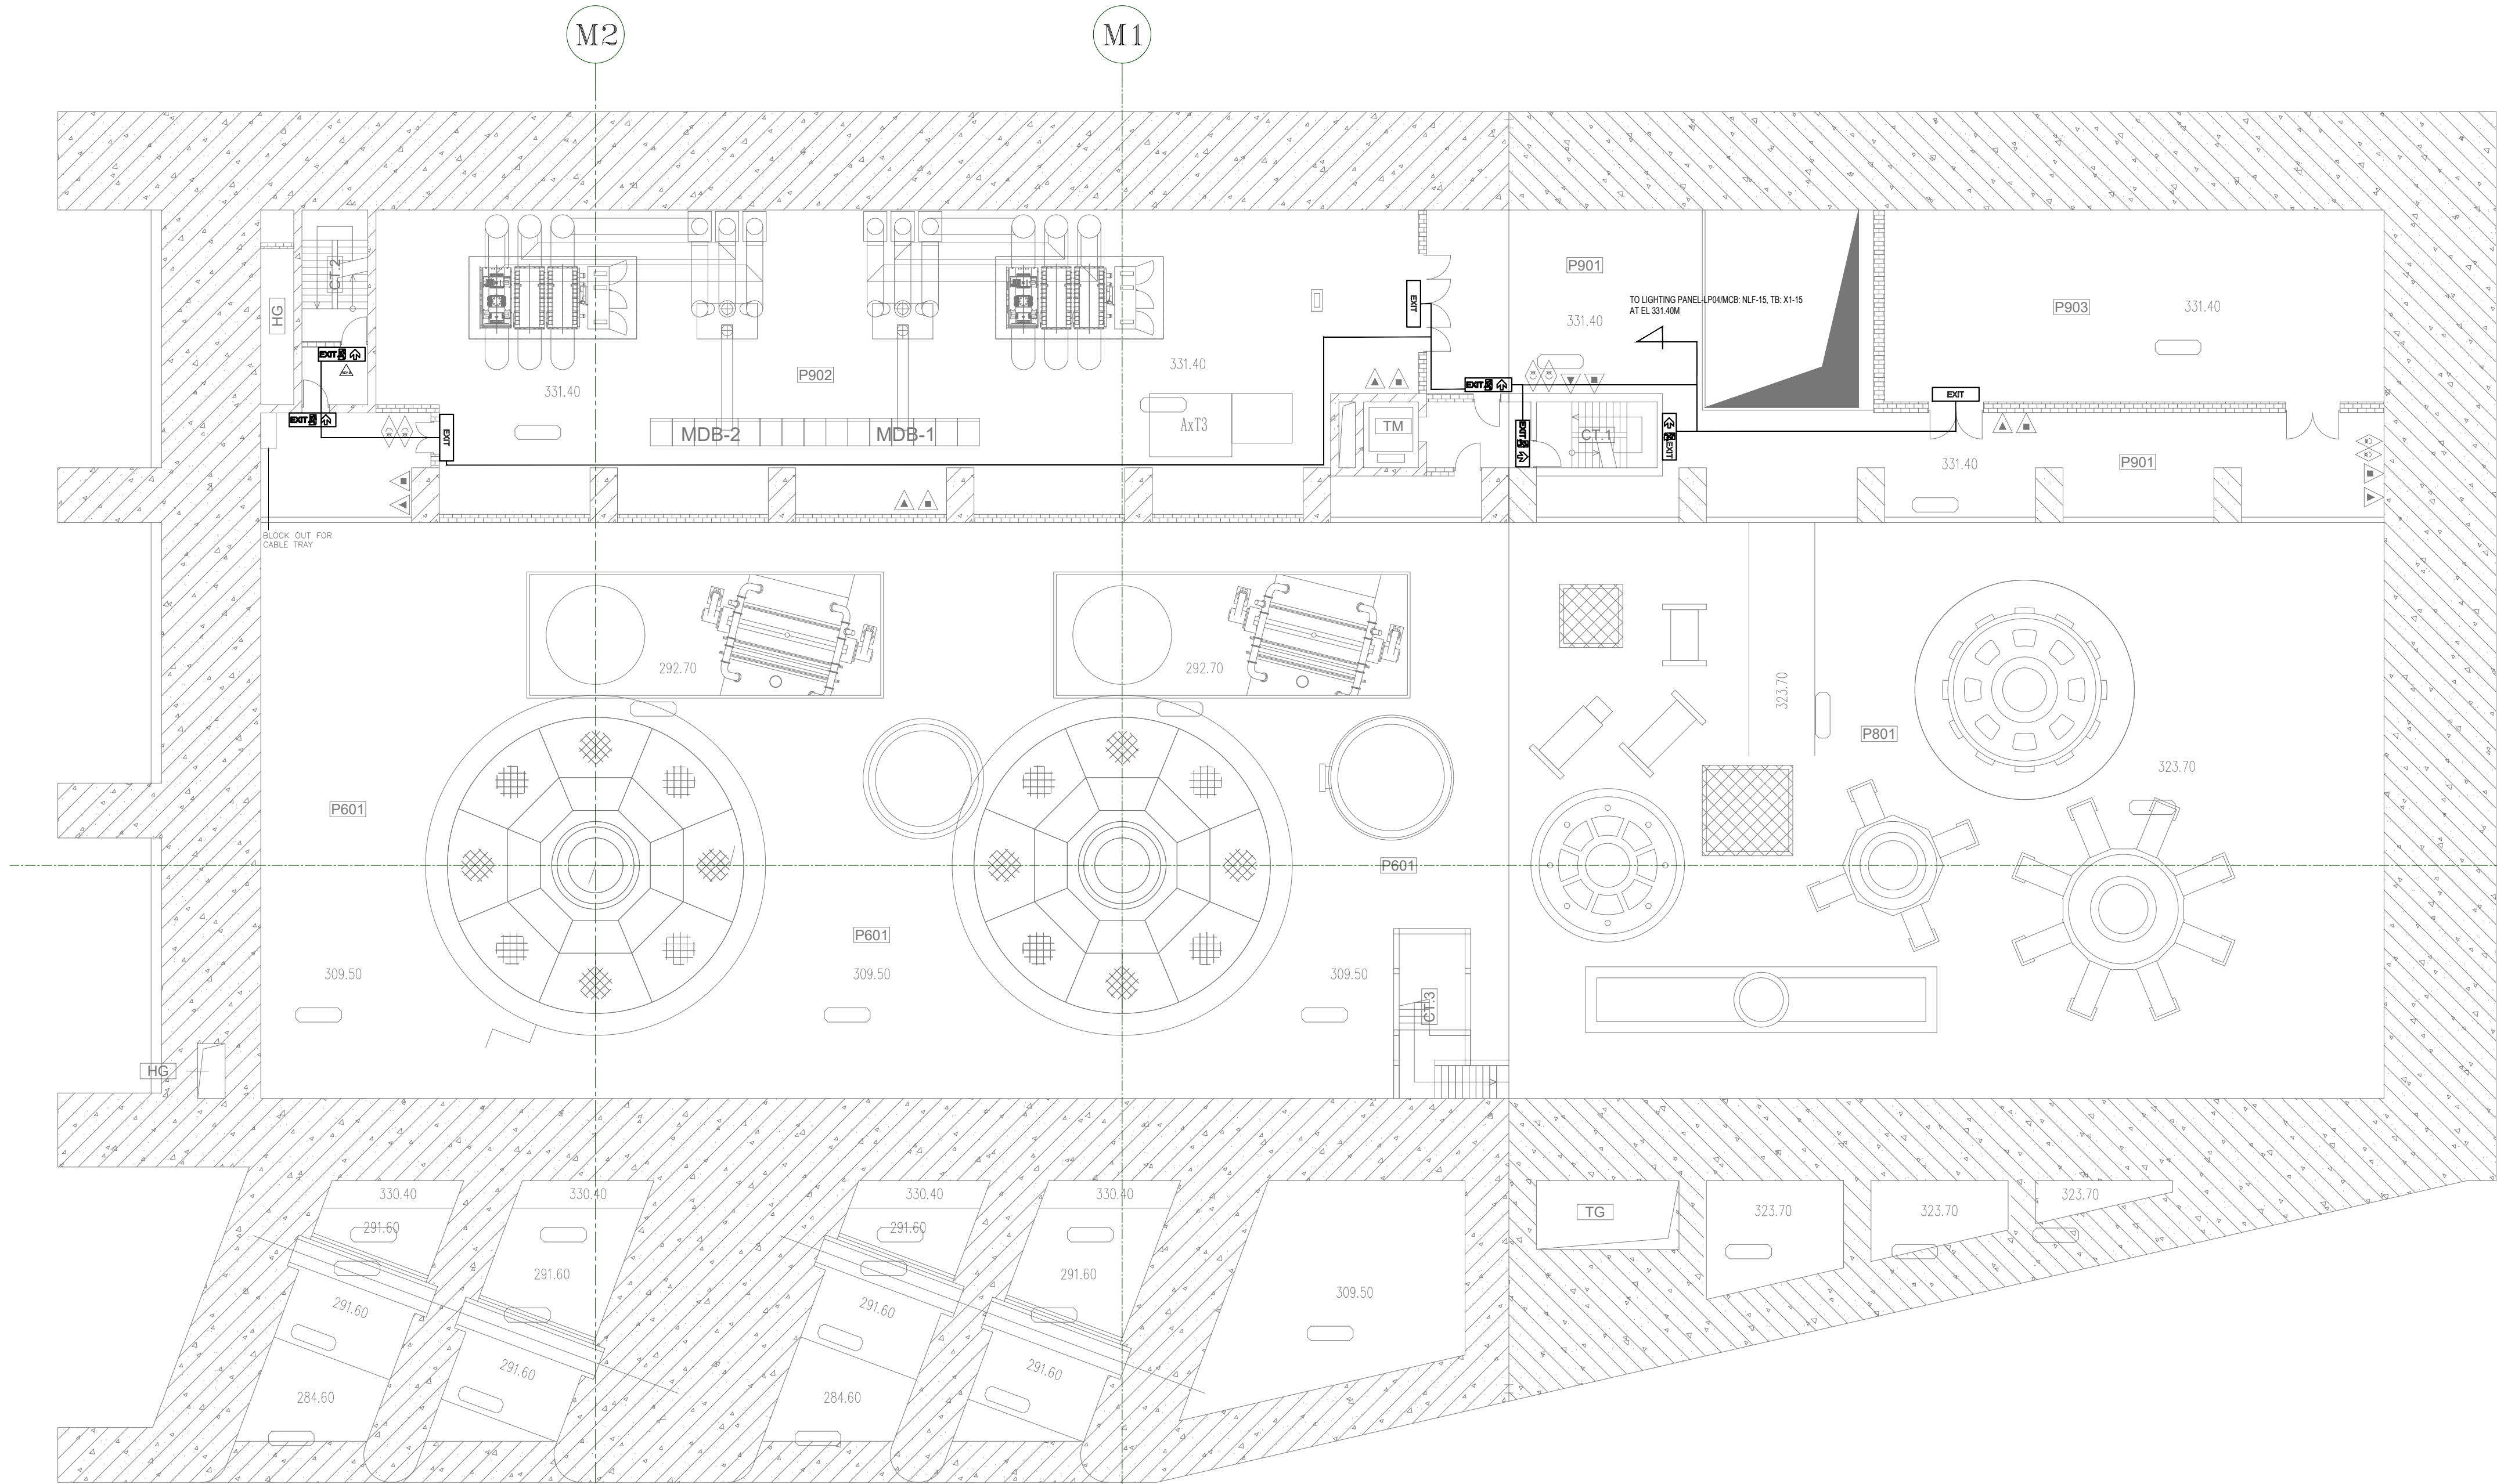

EXIT LAMP
EL. 331.40 PLAN LAYOUT

LEGEND:-

NO.	SYMBOL	DESCRIPTION	Q'ty	REMARK
01.		POWER SUPPLY FOR LIGHTING SYSTEM	-	BY AH
02.		FIRE EXIT TO UPSTAIRS	4	
03.		FIRE EXIT TO RIGHT	1	
04.		FIRE EXIT TO LEFT	-	
05.		FIRE EXIT	3	

REV B



PURCHASER : **POWER PROJECTS MANAGEMENT BOARD NO. 2 - BRANCH OF VIETNAM ELECTRICITY EVNPMB2)**



ANDRITZ HYDRO GmbH & 3 C INCORPORATION

PROJECT :

**ITALY HYDRO POWER PLANT EXTENSION (2X180MW)
PACKAGE- NO.40 TB-01 (VIETNAM)**

AS-BUILT DRAWINGS	22.Jan.24	N.V.T	D.V.L	LD	
REVISED AS PER CLIENT COMMENTS VIDE LETTER NO. 0709	27.Nov.23	N.V.T	D.V.L	LD	
INITIAL SUBMISSION					
Index	Änderung Modification	Datum Date	Bearbeitet Prepared by	Geprüft Checked	Genehmigt Approved
Stückliste/Partslist	WA Nr.				
Abmess./Dimension	Klassen Nr.				
Gruppe/Group	Type				
LAYOUT DRAWING FIRE DETECTION & ALARM SYSTEM					Maßstab/Scale
					Gewicht/Weight
					Material
HAV	Datum/Date	Name	Kunde/Client	Schutzvermerk	
Gez./Drawn	24.12.2022	NK	Anlage/Plant	ISO 16016 beachten	
Gepr./Checked	24.12.2022	JCP	Projekt/Project	Refer to protection notice ISO 16016	
Gepr./Checked	24.12.2022	BRS	Vertr./Contract	Ähnl./Similar	
Genehm./Appr.	24.12.2022	JCP	File	Ers./Replace	

ANDRITZ

XXXX


Zeichnungs N°/Drawing N°
ITALY-P40-AH-300-LAY-SGA-DG-1931-DI

Index
Bl./Sht. 24
von/of 31

This drawing is the property of
ANDRITZ HYDRO GmbH
Elektronengasse 20 120 Vienna, Austria

Refer the protection notice ISO 15016

CAD: AUSTO1

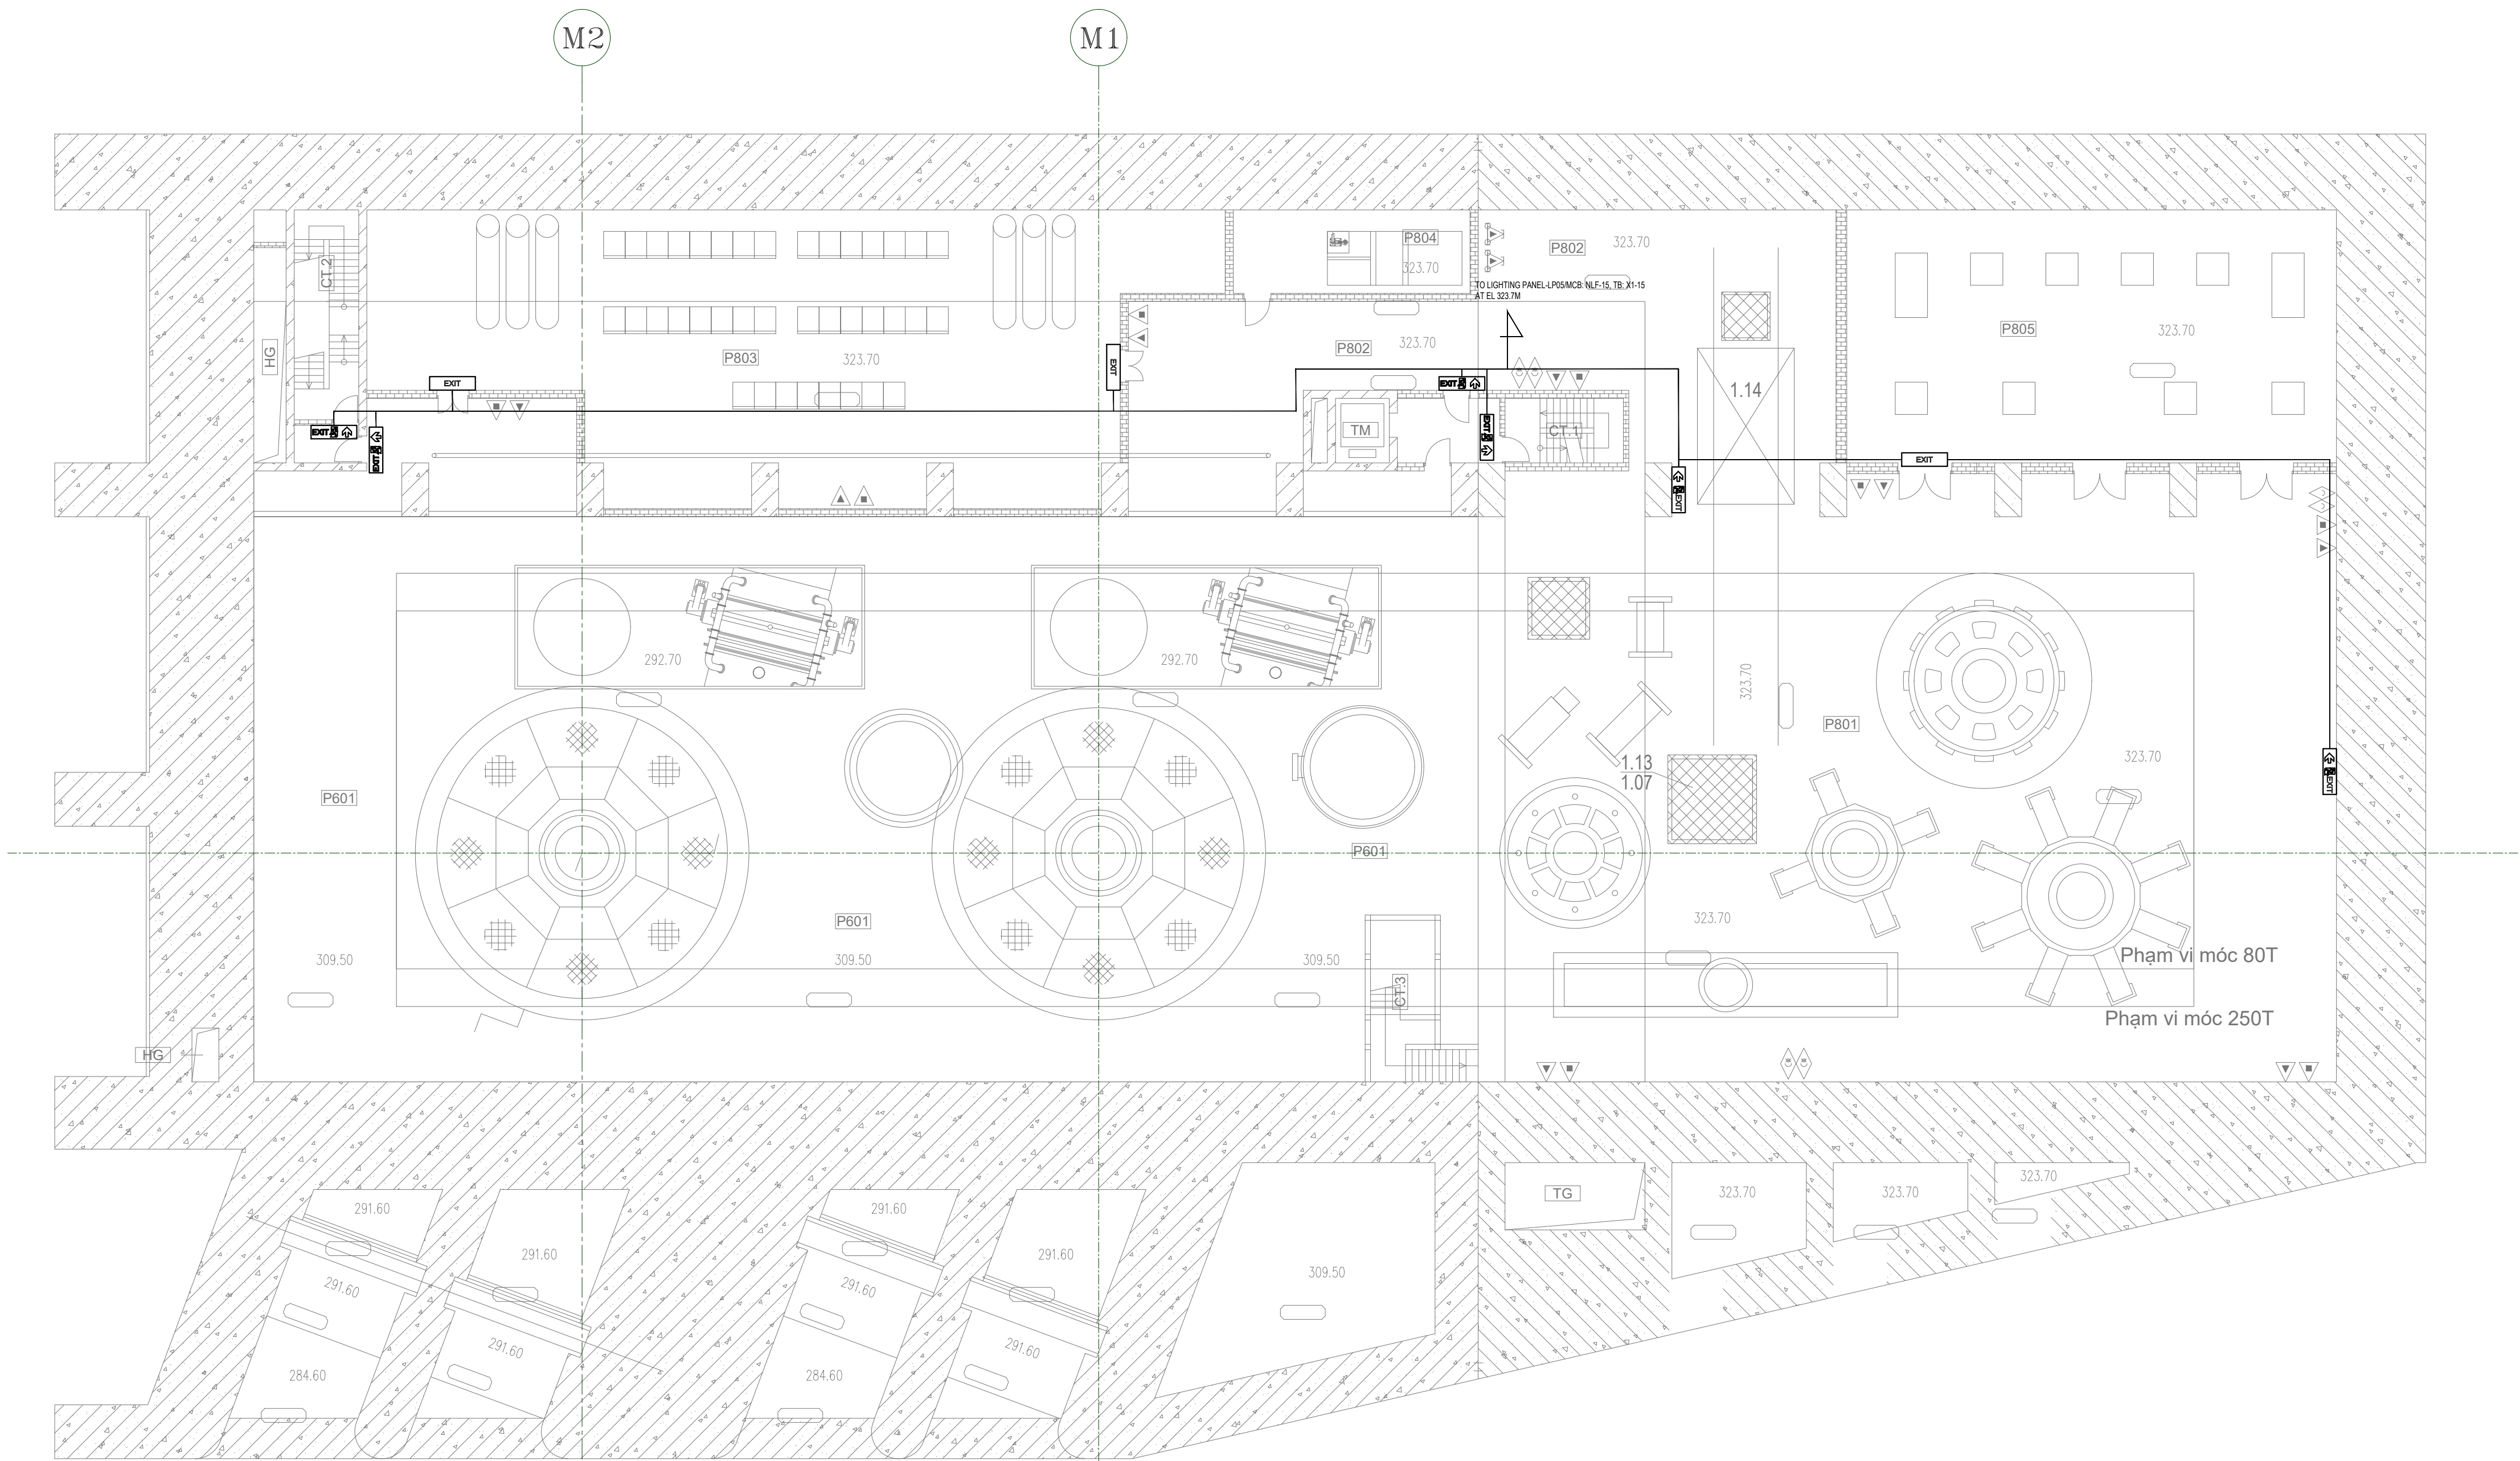

EXIT LAMP
EL. 323.70 PLAN LAYOUT

LEGEND:-

NO.	SYMBOL	DESCRIPTION	Q'ty	REMARK
01.		POWER SUPPLY FOR LIGHTING SYSTEM	-	BY AH
02.		FIRE EXIT TO UPSTAIRS	4	
03.		FIRE EXIT TO RIGHT	2	
04.		FIRE EXIT TO LEFT	-	
05.		FIRE EXIT	3	

REV B



PURCHASER :
POWER PROJECTS MANAGEMENT BOARD NO. 2 - BRANCH OF VIETNAM ELECTRICITY EVNPMB2)



ANDRITZ HYDRO GmbH & 3 C INCORPORATION

PROJECT :

ITALY HYDRO POWER PLANT EXTENSION (2X180MW)
PACKAGE- NO.40 TB-01 (VIETNAM)

AS-BUILT DRAWINGS					
B	REVISED AS PER CLIENT COMMENTS VIDE LETTER NO. 0709	22.Jan.24	N.V.T	D.V.L	LD
A	INITIAL SUBMISSION	27.Nov.23	N.V.T	D.V.L	LD
Index	Änderung Modification	Datum Date	Bearbeitet Prepared by	Geprüft Checked	Genehmigt Approved
Stückliste/Partslist	Abmess./Dimension		WA Nr.		
Gruppe/Group	Type		Klassen Nr.		
Maßstab/Scale			Gewicht/Weight		
Material			Schutzvermerk		
HAY			Date/Date		
Gez./Drawn			Name		
Gepr./Checked			Kunde/Client		
Gepr./Checked			Anlage/Plant		
Genehm./Appr.			Projekt/Project		
Date/Date			Vertr./Contract		
File			Ähnl./Similar		
Interns. N°/Internal N°			Ers./Replace		
XXXX			=		
Zeichnungs N°/Drawing N°			Index		
ITALY-P40-AH-300-LAY-SGA-DG-1931-DI			BL./Sht.		
			von/of		
			31		




Refer the protection notice ISO 15016

This drawing is the property of
ANDRITZ HYDRO GmbH
Elektronengasse 20 120 Vienna, Austria

Refer the protection notice ISO 15016

CAD: AUSTO1

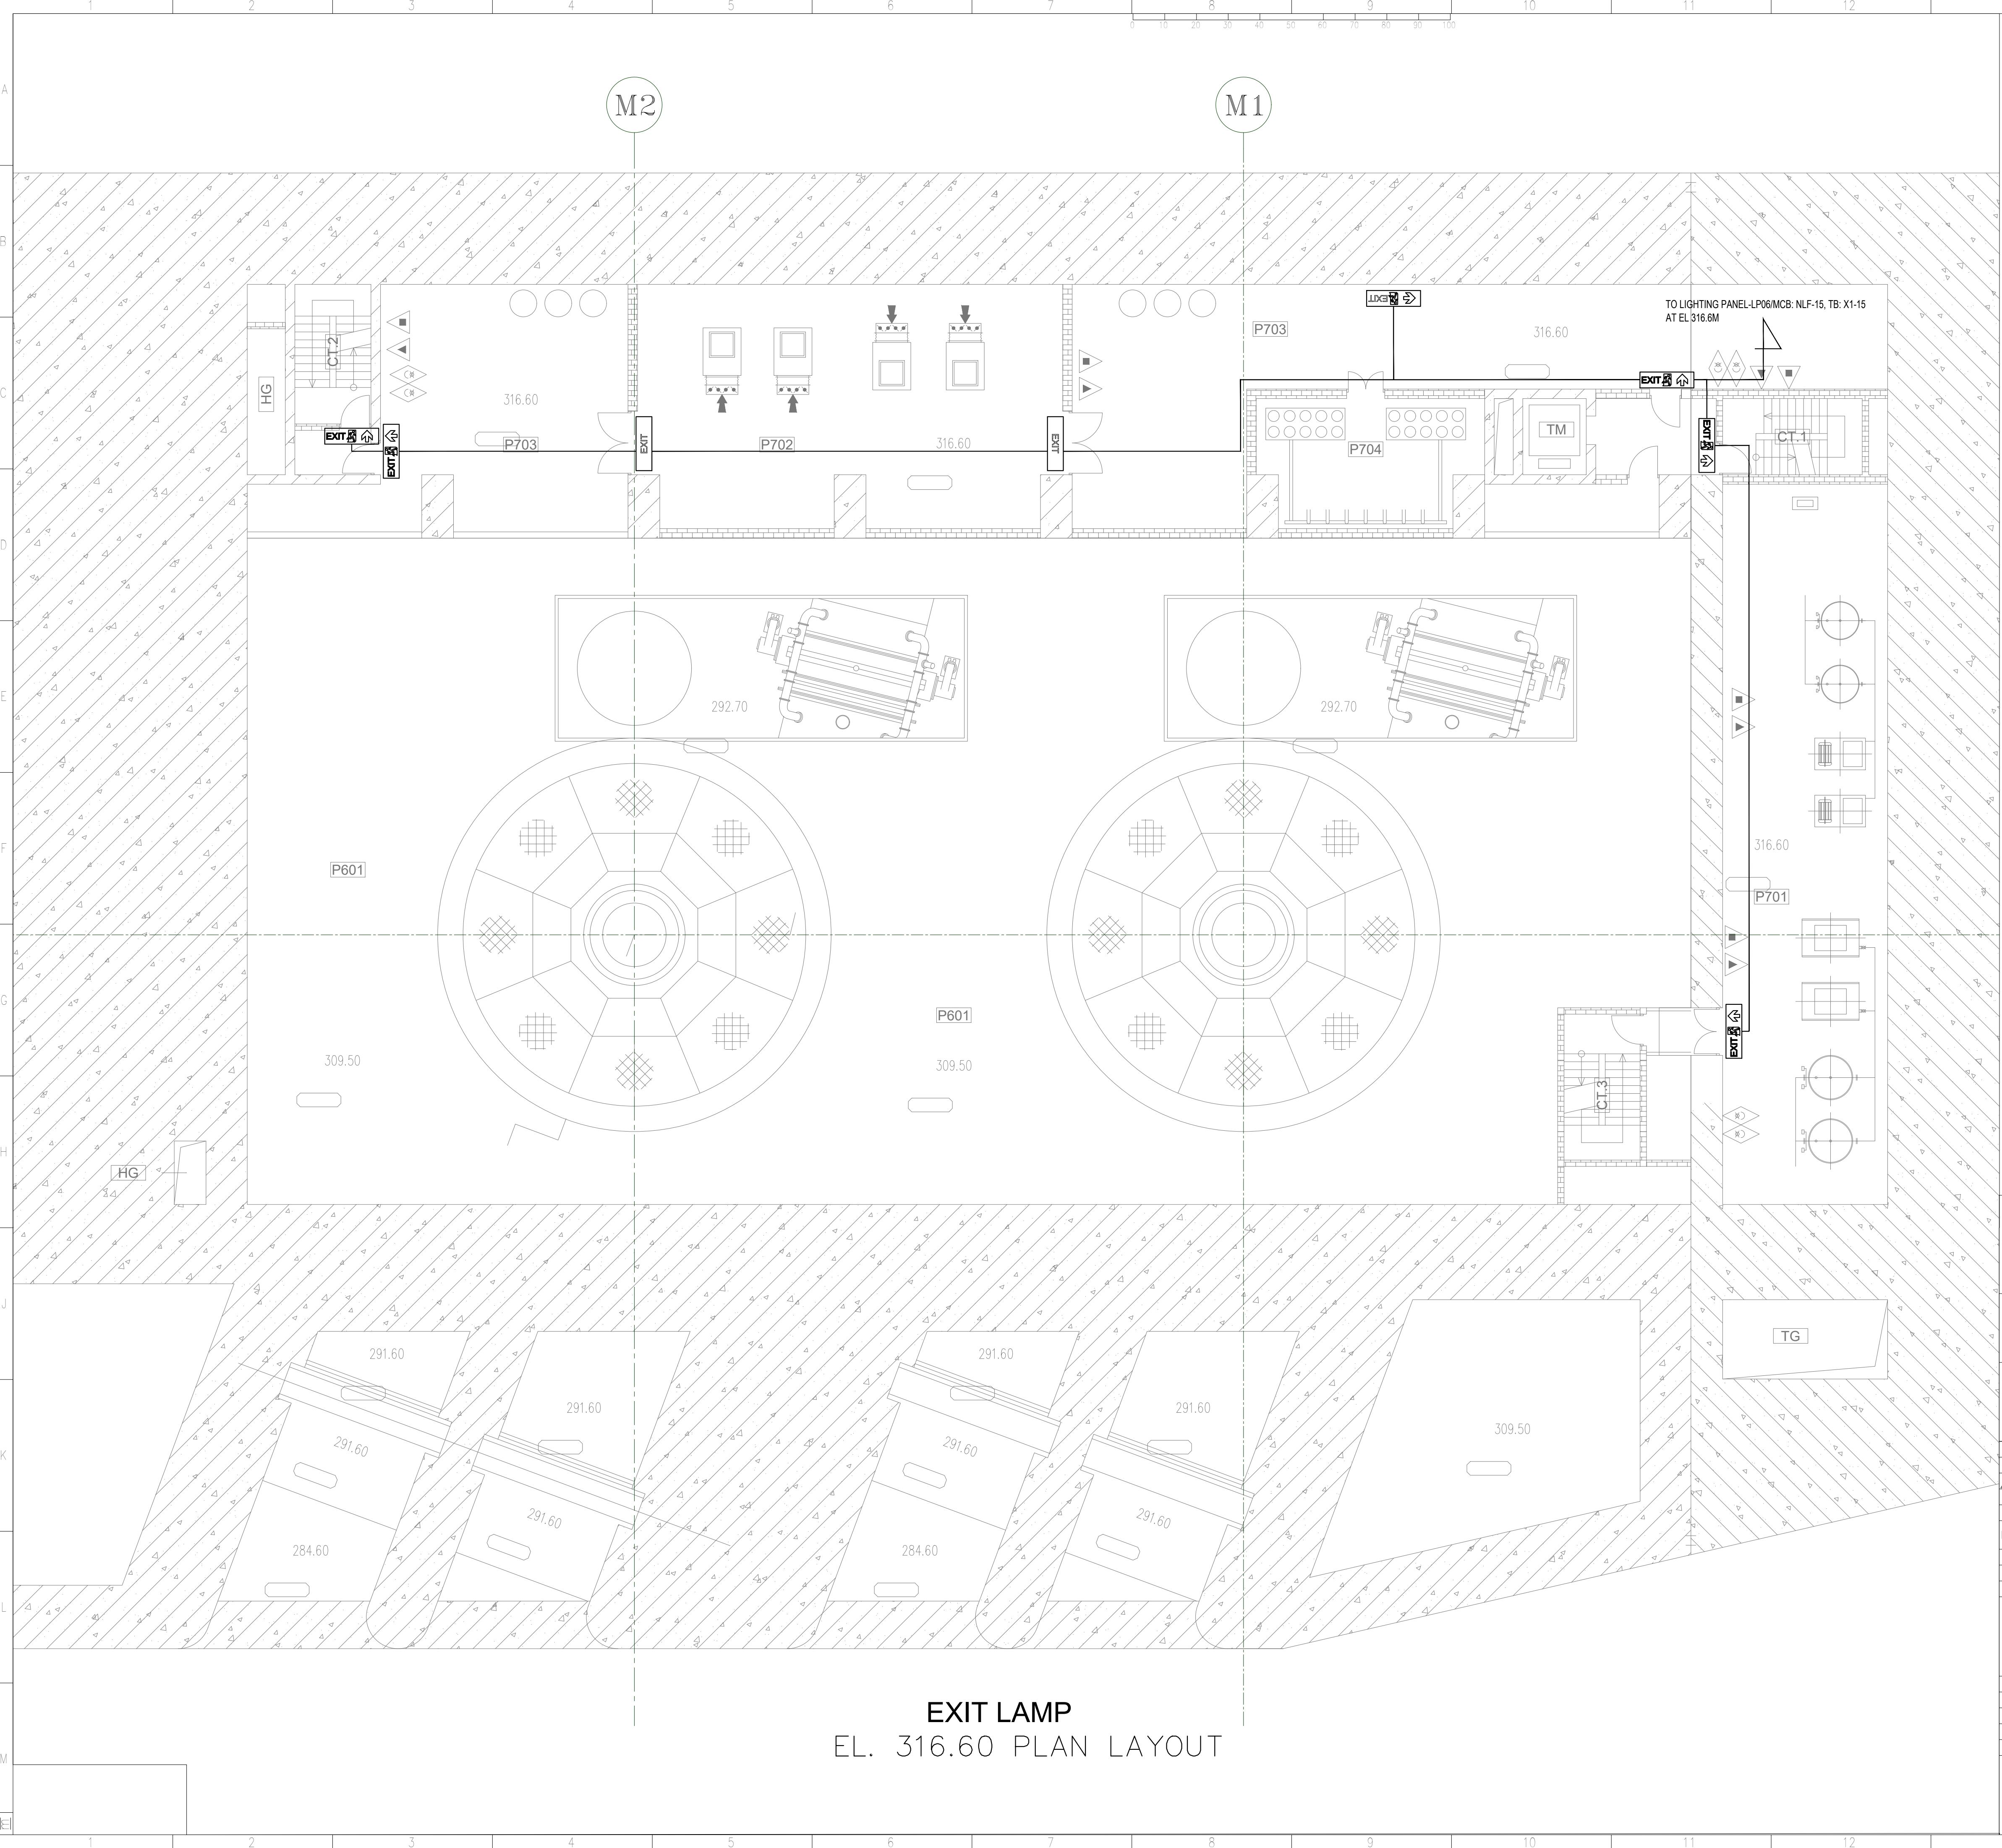

LEGEND:—

NO.	SYMBOL	DESCRIPTION	Q'ty	REMARK
01.		POWER SUPPLY FOR LIGHTING SYSTEM	—	BY AH
02.		FIRE EXIT TO UPSTAIRS	5	
03.		FIRE EXIT TO RIGHT	1	
04.		FIRE EXIT TO LEFT	—	
05.		FIRE EXIT	2	

REV B



PURCHASER : **POWER PROJECTS MANAGEMENT BOARD NO. 2 - BRANCH OF VIETNAM ELECTRICITY EVNPMB2)**



ANDRITZ HYDRO GmbH & 3 C INCORPORATION

PROJECT :


**ITALY HYDRO POWER PLANT EXTENSION (2X180MW)
PACKAGE- NO.40 TB-01 (VIETNAM)**

AS-BUILT DRAWINGS						
B	REVISED AS PER CLIENT COMMENTS VIDE LETTER NO. 0709	22.Jan.24	N.V.T	D.V.L	LD	
A	INITIAL SUBMISSION	27.Nov.23	N.V.T	D.V.L	LD	
Index	Änderung Modification	Datum Date	Bearbeitet Prepared by	Geprüft Checked	Geprüft Checked	Genehmigt Approved
Stückliste/Partlist	WA Nr.					
Abmess./Dimension	Klassen Nr.					
Gruppe/Group	Type					
Maßstab/Scale						
Gewicht/Weight						Material
Schutzvermerk ISO 15016 beachten Refer to protection notice ISO 15016						 ISO / R 128 EUROPE
HAV	Datum/Date	Name	Kunde/Client	Ähnl./Similar		
Gez./Drawn	24.12.2022	NK	Anlage/Plant	Ers./Replace		
Gepr./Checked	24.12.2022	JCP	Projekt/Project	=		
Gepr./Checked	24.12.2022	BRS	Vertr./Contract	+		
Genehm./Appr.	24.12.2022	JCP	File			
			Interne N° XXXX			
			Zeichnungs N°/Drawing N°	Index		
			ITALY-P40-AH-300-LAY-SGA-DG-1931-DI	Bl./Sht. von/of		

This drawing is the property of
ANDRITZ HYDRO GmbH
Elektronengasse 20 120 Vienna, Austria

Refer the protection notice ISO 16016

CAD: AUSTO1

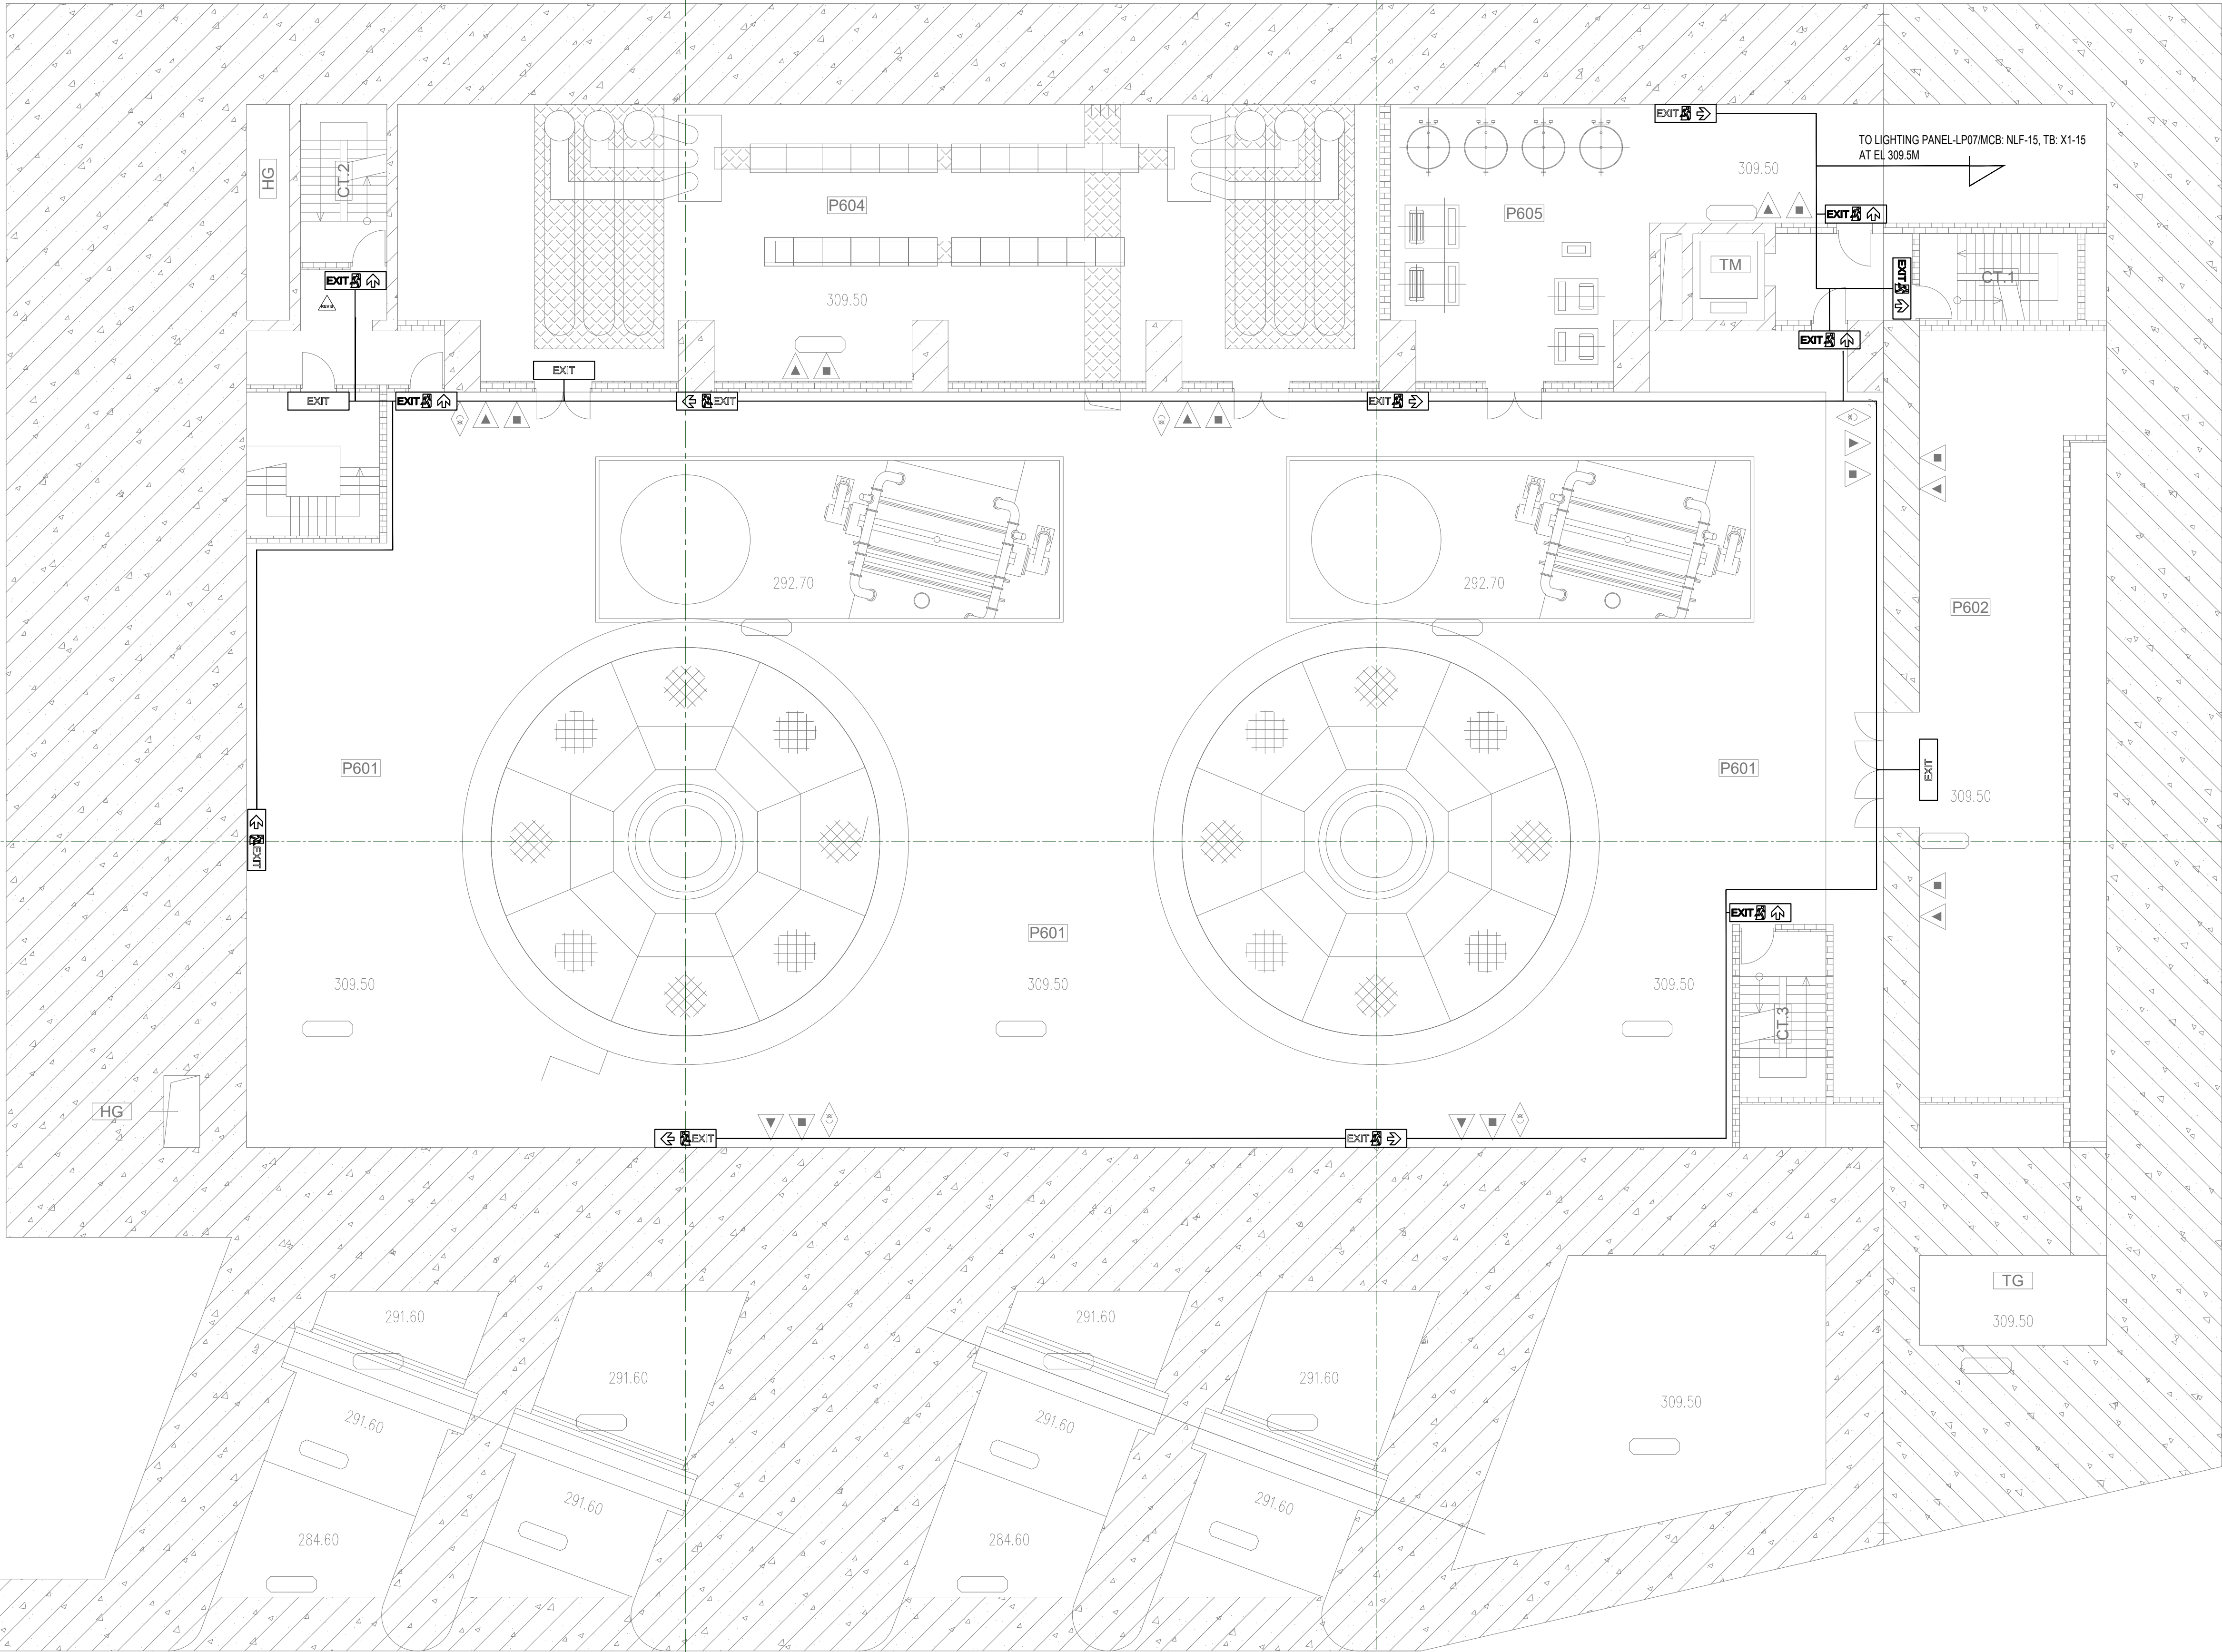

EXIT LAMP
EL. 309.50 PLAN LAYOUT

LEGEND:-

NO.	SYMBOL	DESCRIPTION	Q'ty	REMARK
01.		POWER SUPPLY FOR LIGHTING SYSTEM	-	BY AH
02.		FIRE EXIT TO UPSTAIRS	3	
03.		FIRE EXIT TO RIGHT	3	
04.		FIRE EXIT TO LEFT	3	
05.		FIRE EXIT	6	


REV B

	PURCHASER : POWER PROJECTS MANAGEMENT BOARD NO. 2 - BRANCH OF VIETNAM ELECTRICITY EVNPMB2)																												
	ANDRITZ HYDRO GmbH & 3 C INCORPORATION																												
ITALY HYDRO POWER PLANT EXTENSION (2X180MW) PACKAGE- NO.40 TB-01 (VIETNAM)																													
PROJECT :																													
<table><tr><td></td><td></td><td></td><td></td><td></td><td></td></tr><tr><td>★</td><td>AS-BUILT DRAWINGS</td><td></td><td></td><td></td><td></td></tr><tr><td>B</td><td>REVISED AS PER CLIENT COMMENTS VIDE LETTER NO. 0709</td><td>22.Jan.24</td><td>N.V.T</td><td>D.V.L</td><td>LD</td></tr><tr><td>A</td><td>INITIAL SUBMISSION</td><td>27.Nov.23</td><td>N.V.T</td><td>D.V.L</td><td>LD</td></tr></table>												★	AS-BUILT DRAWINGS					B	REVISED AS PER CLIENT COMMENTS VIDE LETTER NO. 0709	22.Jan.24	N.V.T	D.V.L	LD	A	INITIAL SUBMISSION	27.Nov.23	N.V.T	D.V.L	LD
★	AS-BUILT DRAWINGS																												
B	REVISED AS PER CLIENT COMMENTS VIDE LETTER NO. 0709	22.Jan.24	N.V.T	D.V.L	LD																								
A	INITIAL SUBMISSION	27.Nov.23	N.V.T	D.V.L	LD																								
Index	Änderung Modification	Datum Date	Bearbeitet Prepared by	Geprüft Checked	Genehmigt Approved																								
Stückliste/Partlist			WA Nr.																										
Abmess./Dimension			Klassen Nr.																										
Gruppe/Group			Type																										
			Maßstab/Scale																										
			Gewicht/Weight		Material																								
HAY	Datum/Date	Name	Kunde/Client	POWER PROJECTS MANAGEMENT BOARD NO. 2 (DPMB2)																									
Gez./Drawn	24.12.2022	NK	Anlage/Plant	ITALY HYDRO POWER PLANT EXTENSION																									
Gepr./Checked	24.12.2022	JCP	Projekt/Project	N° 24/IALYMR/2022/HB-A02-AH-3C																									
Gepr./Checked	24.12.2022	BRS	Vertr./Contract	N° 24/IALYMR/2022/HB-A02-AH-3C																									
Genehm./Appr.	24.12.2022	JCP	File	Ähnl./Similar																									
			Interne N°/Internal N°	=																									
			XXXX	+																									
			Zeichnungs N°/Drawing N°	Index																									
			ITALY-P40-AH-300-LAY-SGA-DG-1931-DI	BL./Sht. 27 von/of 31																									

This drawing is the property of
ANDRITZ HYDRO GmbH
Elektronengasse 20 120 Vienna, Austria

Refer the protection notice ISO 15016

CAD: AUSTO1

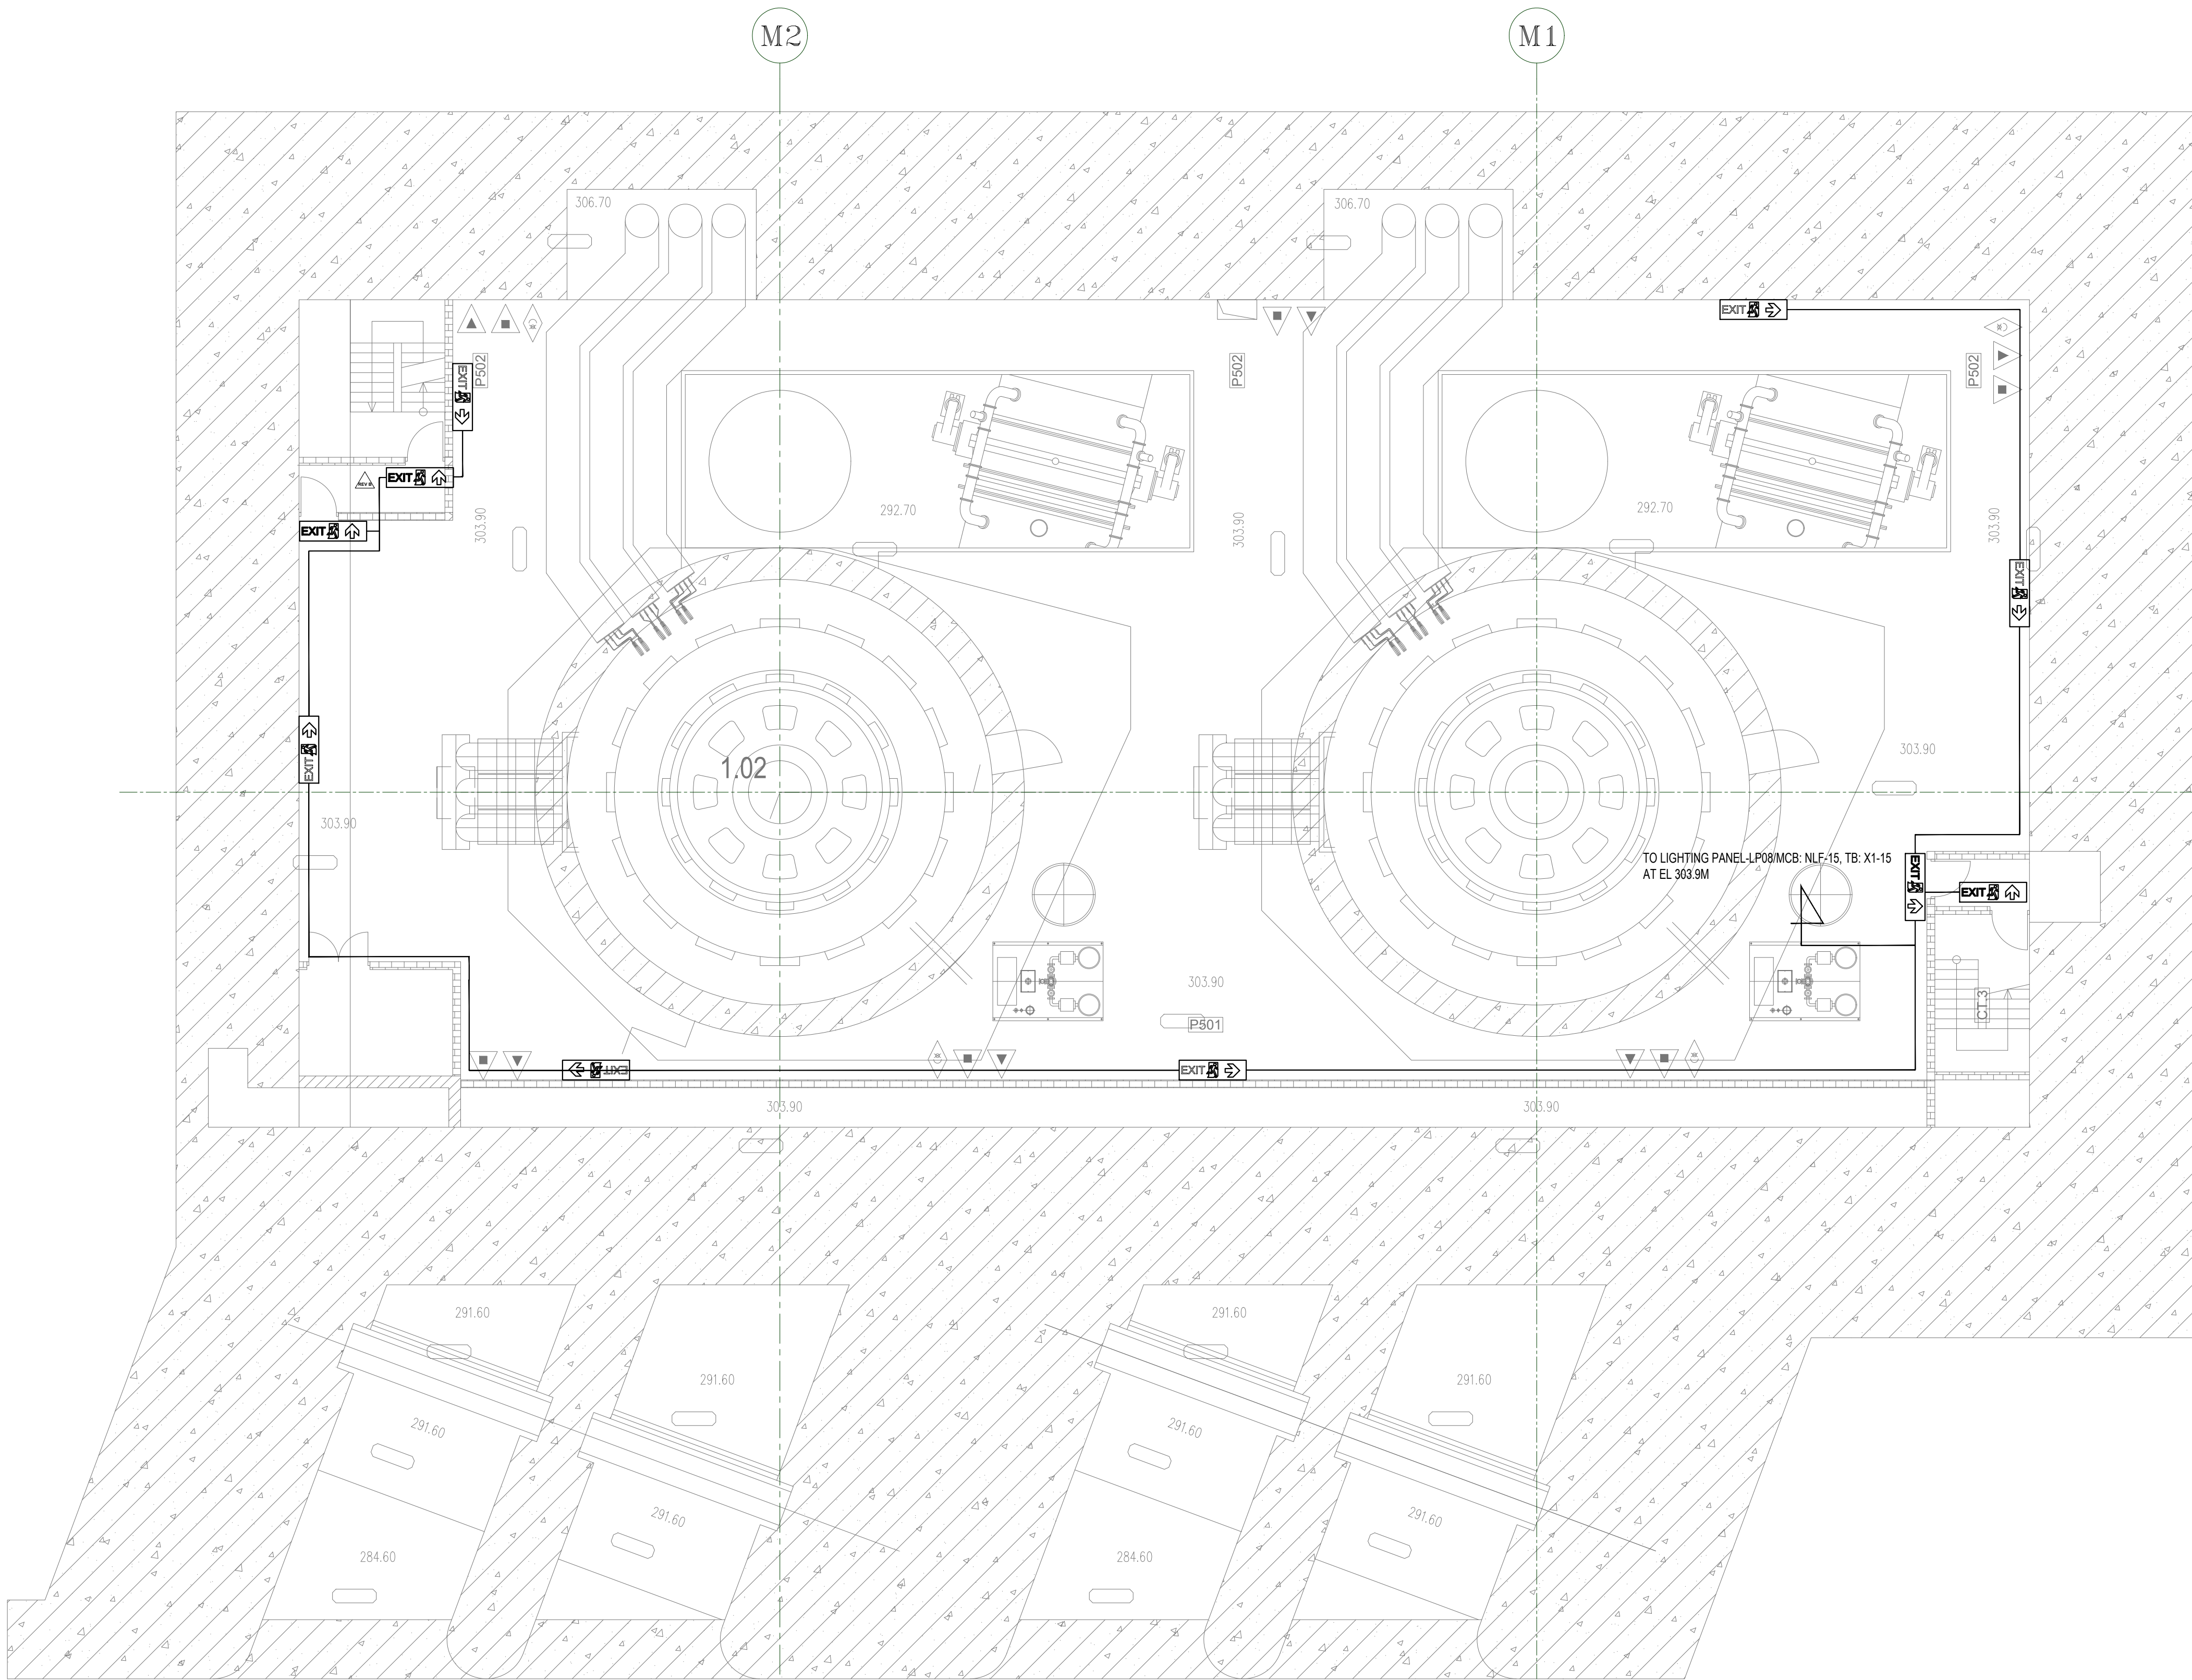

EXIT LAMP
EL. 303.90 PLAN LAYOUT

LEGEND:--

NO.	SYMBOL	DESCRIPTION	Q'ty	REMARK
01.		POWER SUPPLY FOR LIGHTING SYSTEM	-	BY AH
02.		FIRE EXIT TO UPSTAIRS	4	
03.		FIRE EXIT TO RIGHT	6	
04.		FIRE EXIT TO LEFT	3	
05.		FIRE EXIT	-	

REV B



PURCHASER : **POWER PROJECTS MANAGEMENT
BOARD NO. 2 - BRANCH OF
VIETNAM ELECTRICITY EVNPMB2)**



ANDRITZ HYDRO GmbH & 3 C INCORPORATION

PROJECT :

**ITALY HYDRO POWER PLANT EXTENSION
(2X180MW)
PACKAGE- NO.40 TB-01 (VIETNAM)**

AS-BUILT DRAWINGS					
B REVISED AS PER CLIENT COMMENTS VIDE LETTER NO. 0709	22.Jan.24	N.V.T	D.V.L	LD	
A INITIAL SUBMISSION	27.Nov.23	N.V.T	D.V.L	LD	

Index	Änderung Modification	Datum Date	Bearbeitet Prepared by	Geprüft Checked	Geprüft Checked	Genehmigt Approved
-------	--------------------------	---------------	---------------------------	--------------------	--------------------	-----------------------

Stückliste/Partslist	WA Nr.
Abmess./Dimension	Klassen Nr.
Gruppe/Group	Type

LAYOUT DRAWING FIRE DETECTION & ALARM SYSTEM		Maßstab/Scale
---	--	---------------

Gewicht/Weight	Material
----------------	----------

HAY	Datum/Date	Name	Kunde/Client	POWER PROJECTS MANAGEMENT BOARD NO. 2 (VNPMB2)	Schutzvermerk
Gez./Drawn	24.12.2022	NK	Anlage/Plant	ITALY HYDRO POWER PLANT EXTENSION	ISO 15016 beachten
Gepr./Checked	24.12.2022	JCP	Projekt/Project	N° 24/IALYMR/2022/HO-A02-AH-3C	Refer to protection notice ISO 15016
Gepr./Checked	24.12.2022	BRS	Vertr./Contract	N° 24/IALYMR/2022/HO-A02-AH-3C	Ähnl./Similar
Genehm./Appr.	24.12.2022	JCP	File		Ers./Replace

ANDRITZ

XXXX


Zeichnungs N°/Drawing N°

ITALY-P40-AH-300-LAY-SGA-DG-1931-DI

Index

Bl./Sht. 28


von/of 31

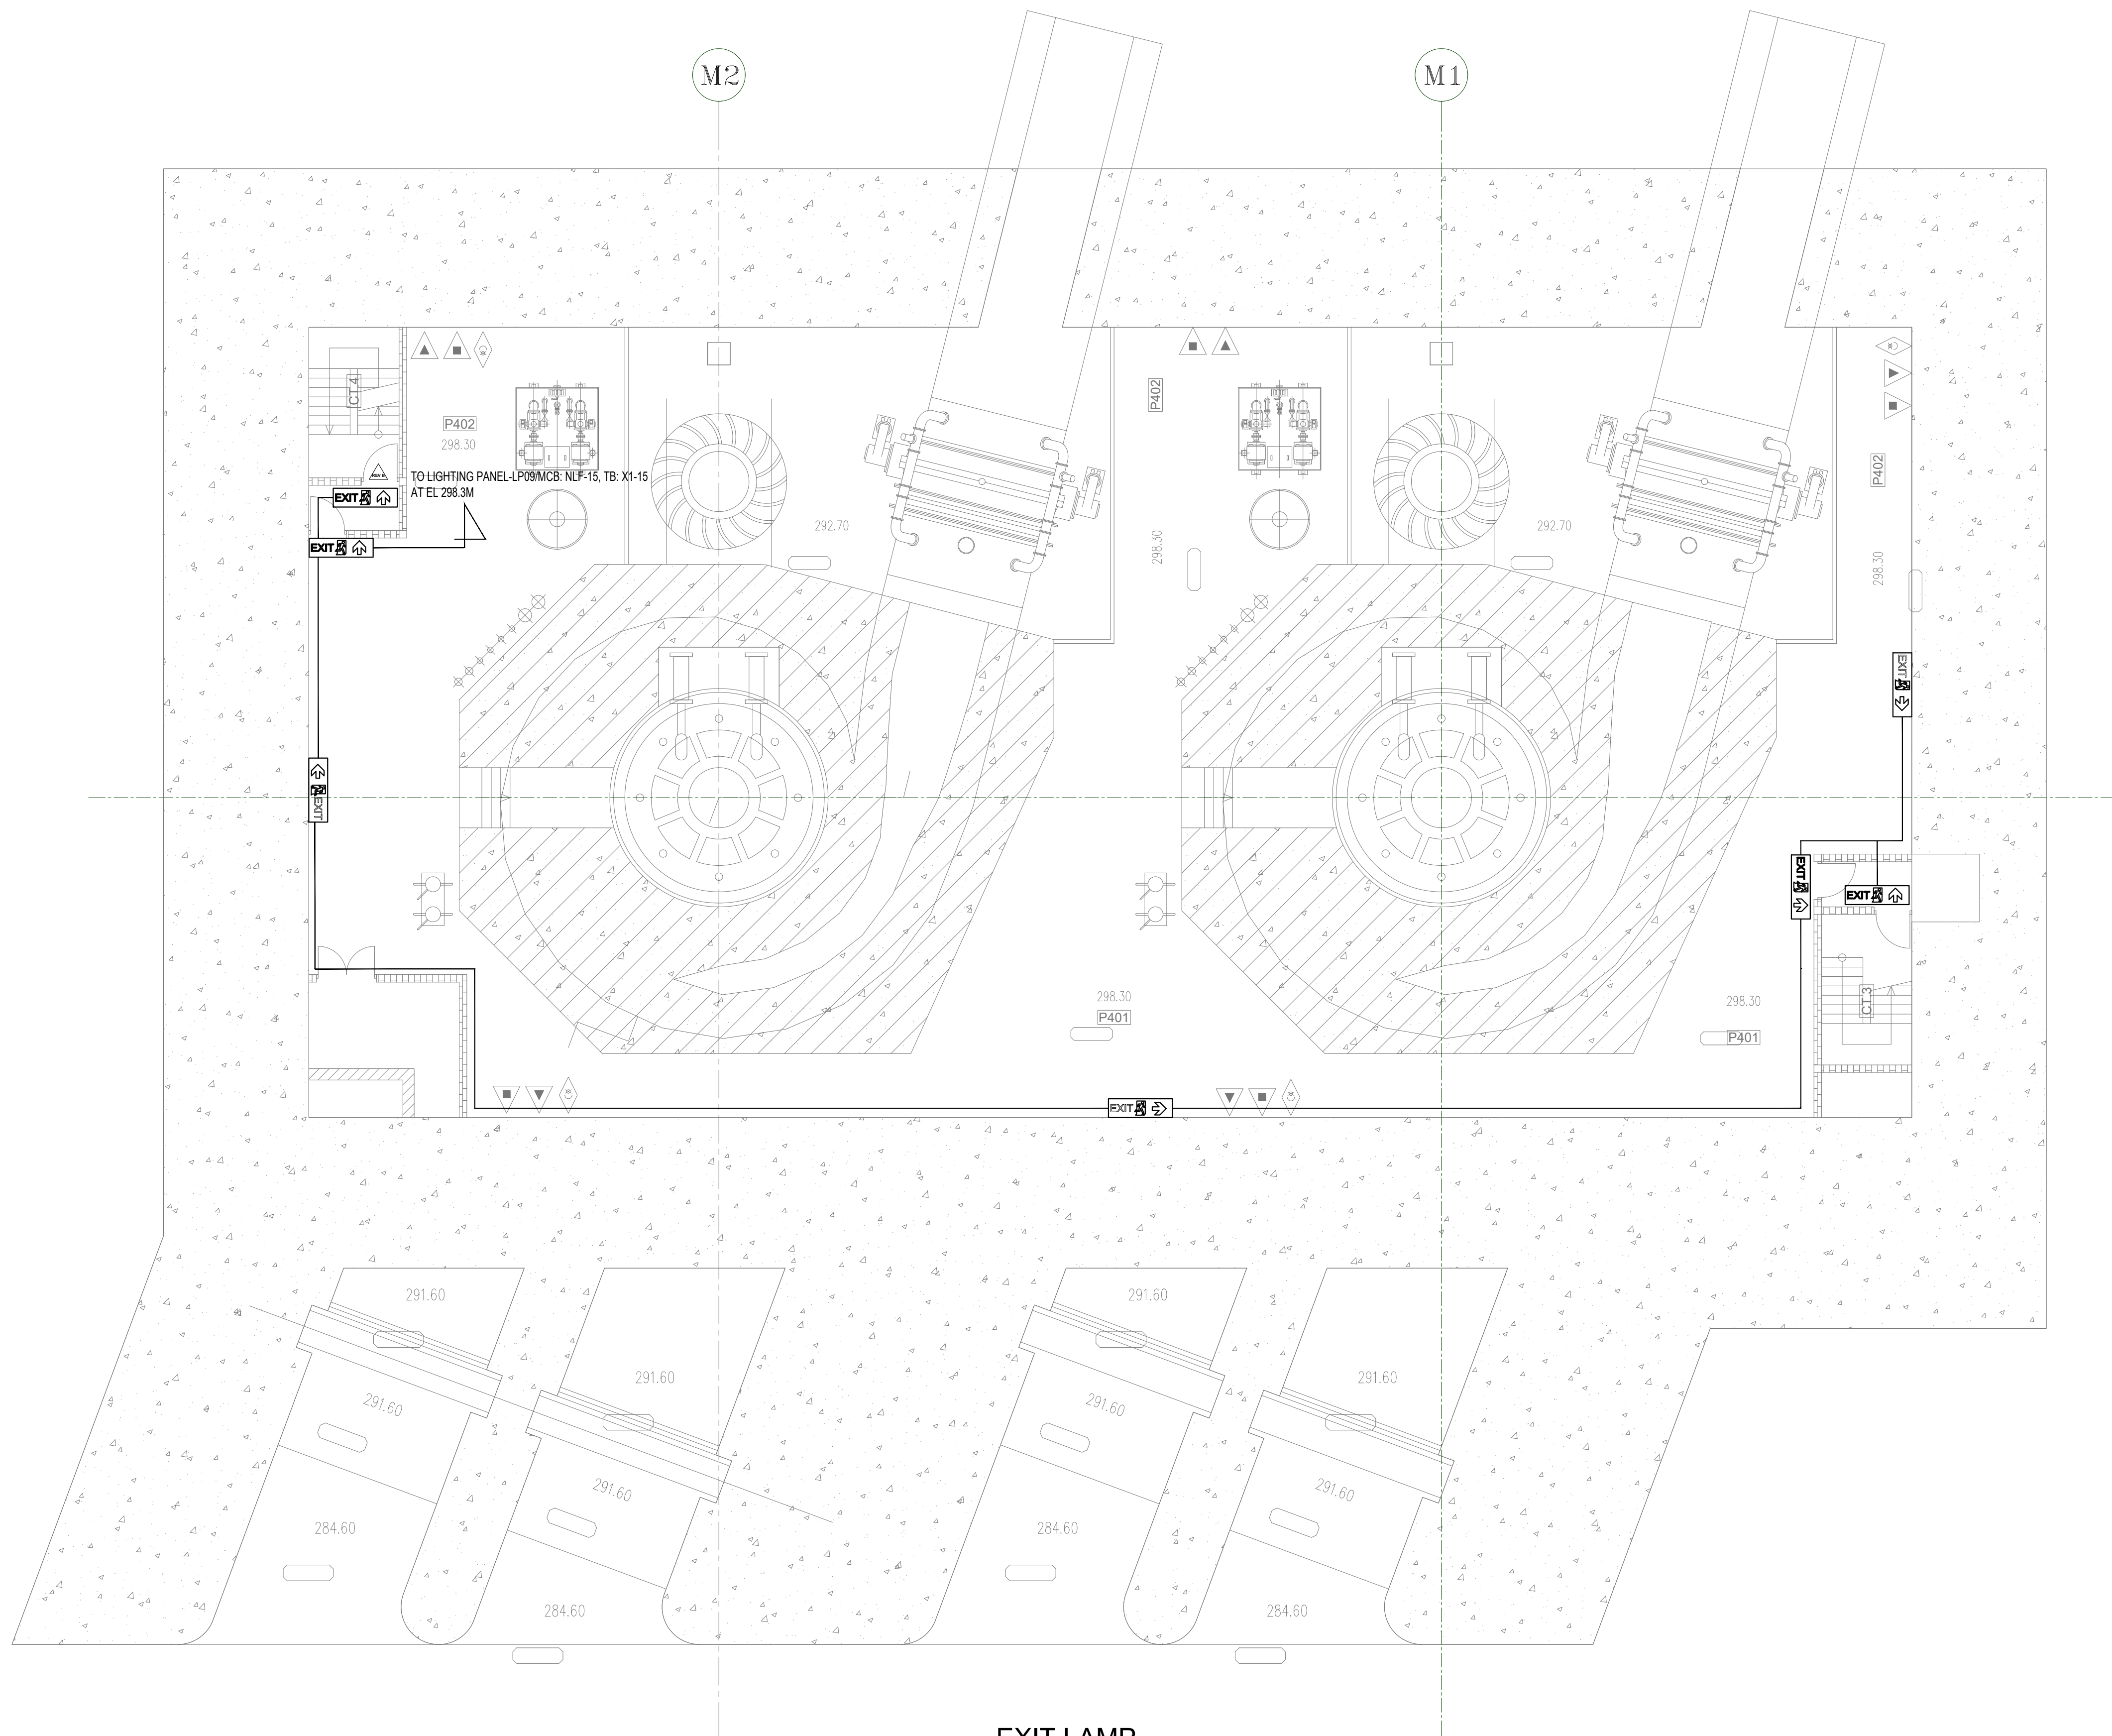


EXIT LAMP
EL. 298.30 PLAN LAYOUT

LEGEND:-

NO.	SYMBOL	DESCRIPTION	Q'ty	REMARK
01.		POWER SUPPLY FOR LIGHTING SYSTEM	-	BY AH
02.		FIRE EXIT TO UPSTAIRS	4	
03.		FIRE EXIT TO RIGHT	2	
04.		FIRE EXIT TO LEFT	1	
05.		FIRE EXIT	-	

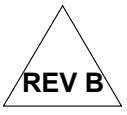

	PURCHASER : POWER PROJECTS MANAGEMENT BOARD NO. 2 - BRANCH OF VIETNAM ELECTRICITY EVNPMB2)
	ANDRITZ HYDRO GmbH & 3 C INCORPORATION
PROJECT :	ITALY HYDRO POWER PLANT EXTENSION (2X180MW) PACKAGE- NO.40 TB-01 (VIETNAM)
	AS-BUILT DRAWINGS
B	REVISED AS PER CLIENT COMMENTS VIDE LETTER NO. 0709
A	INITIAL SUBMISSION
Index	Änderung Modification
Datum Date	22.Jan.24
Bearbeitet Prepared by	N.V.T
Geprüft Checked	D.V.L
Geprüft Checked	LD
Genehmigt Approved	
Stückliste/Partslist	WA Nr.
Abmess./Dimension	Klassen Nr.
Gruppe/Group	Type
	Maßstab/Scale
LAYOUT DRAWING FIRE DETECTION & ALARM SYSTEM	
Gewicht/Weight	
Material	
HAV	Datum/Date
Gez./Drawn	24.12.2022
NK	Name
Kunde/Client	POWER PROJECTS MANAGEMENT BOARD NO. 2 (DPMB2)
Anlage/Plant	ITALY HYDRO POWER PLANT EXTENSION
Gepr./Checked	24.12.2022
JCP	Projekt/Project
N° 24/IALYMR/2022/H0-A02-AH-3C	
Gepr./Checked	24.12.2022
BRS	Vertr./Contract
N° 24/IALYMR/2022/H0-A02-AH-3C	
Genehm./Appr.	24.12.2022
JCP	File
Interne N°/Internal N°	XXXX
Zeichnungs N°/Drawing N°	IALY-P40-AH-300-LAY-SGA-DG-1931-DI
Index	BL./Sht.
29	
von/of	31

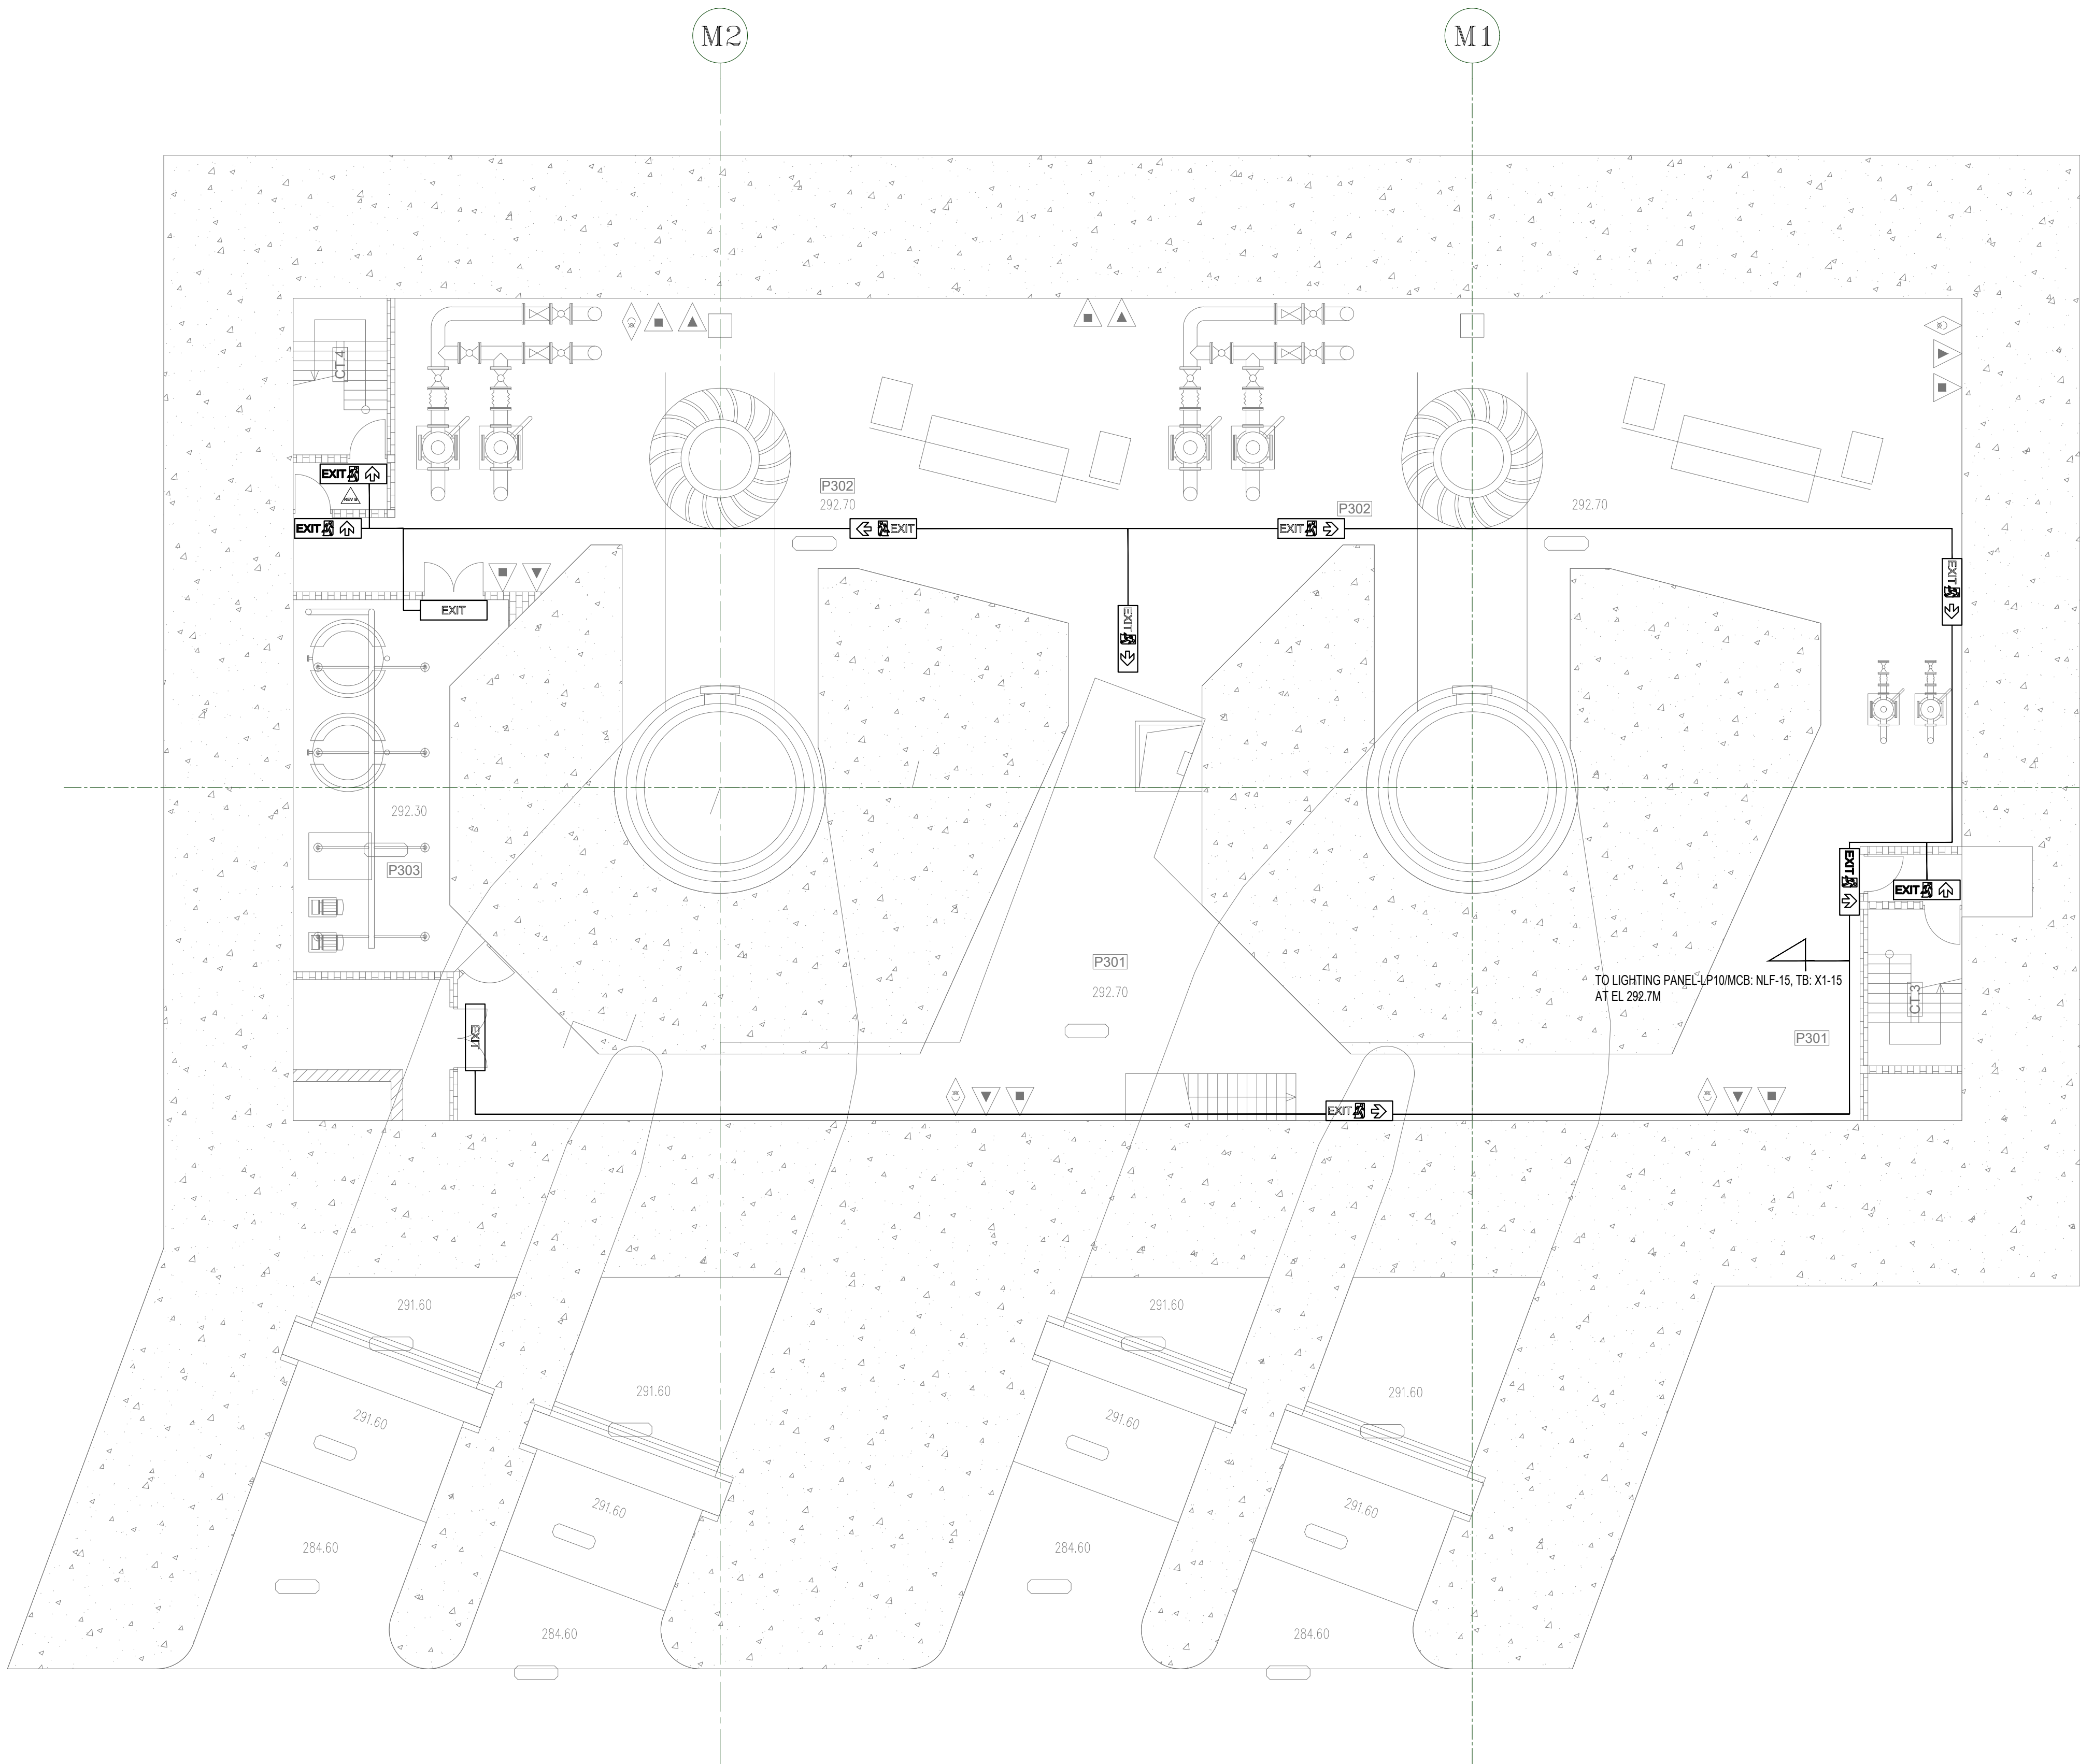

EXIT LAMP AND EMERGENCY LAMP
EL. 292.70 PLAN LAYOUT

LEGEND:-

NO.	SYMBOL	DESCRIPTION	Q'ty	REMARK
01.		POWER SUPPLY FOR LIGHTING SYSTEM	-	BY AH
02.		FIRE EXIT TO UPSTAIRS	4	
03.		FIRE EXIT TO RIGHT	3	
04.		FIRE EXIT TO LEFT	2	
05.		FIRE EXIT	2	

REV B



PURCHASER : **POWER PROJECTS MANAGEMENT
BOARD NO. 2 - BRANCH OF
VIETNAM ELECTRICITY EVNPMB2)**



ANDRITZ HYDRO GmbH & 3 C INCORPORATION

PROJECT :

**ITALY HYDRO POWER PLANT EXTENSION
(2X180MW)
PACKAGE- NO.40 TB-01 (VIETNAM)**

AS-BUILT DRAWINGS	22.Jan.24	N.V.T	D.V.L	LD
REVISED AS PER CLIENT COMMENTS VIDE LETTER NO. 0709	27.Nov.23	N.V.T	D.V.L	LD

INDEX	Änderung Modification	Datum Date	Bearbeitet Prepared by	Geprüft Checked	Geprüft Checked	Genehmigt Approved
-------	--------------------------	---------------	---------------------------	--------------------	--------------------	-----------------------

Stückliste/Partslist	WA Nr.
Abmess./Dimension	Klassen Nr.
Gruppe/Group	Type

Maßstab/Scale

LAYOUT DRAWING FIRE DETECTION &
ALARM SYSTEM

HAY	Datum/Date	Name	Kunde/Client	POWER PROJECTS MANAGEMENT BOARD NO. 2 (DPMB2)	Schutzvermerk ISO 15016 beachten Refer to protection notice ISO 15016	
Gez./Drawn	24.12.2022	NK	Anlage/Plant	ITALY HYDRO POWER PLANT EXTENSION		
Gepr./Checked	24.12.2022	JCP	Projekt/Project	N° 24/IALYMR/2022/H0-A02-AH-3C		
Gepr./Checked	24.12.2022	BRS	Vertr./Contract	N° 24/IALYMR/2022/H0-A02-AH-3C	Ähnl./Similar	
Genehm./Appr.	24.12.2022	JCP	File		Ers./Replace	


ANDRITZ

Interne N°/Internal N°	XXXX
Zeichnungs N°/Drawing N°	ITALY-P40-AH-300-LAY-SGA-DG-1931-DI
Index	30
von/vf	31

This drawing is the property of
ANDRITZ HYDRO GmbH
Elektronengasse 20 120 Vienna, Austria

Refer the protection notice ISO 15016

CAD: AUSTO1

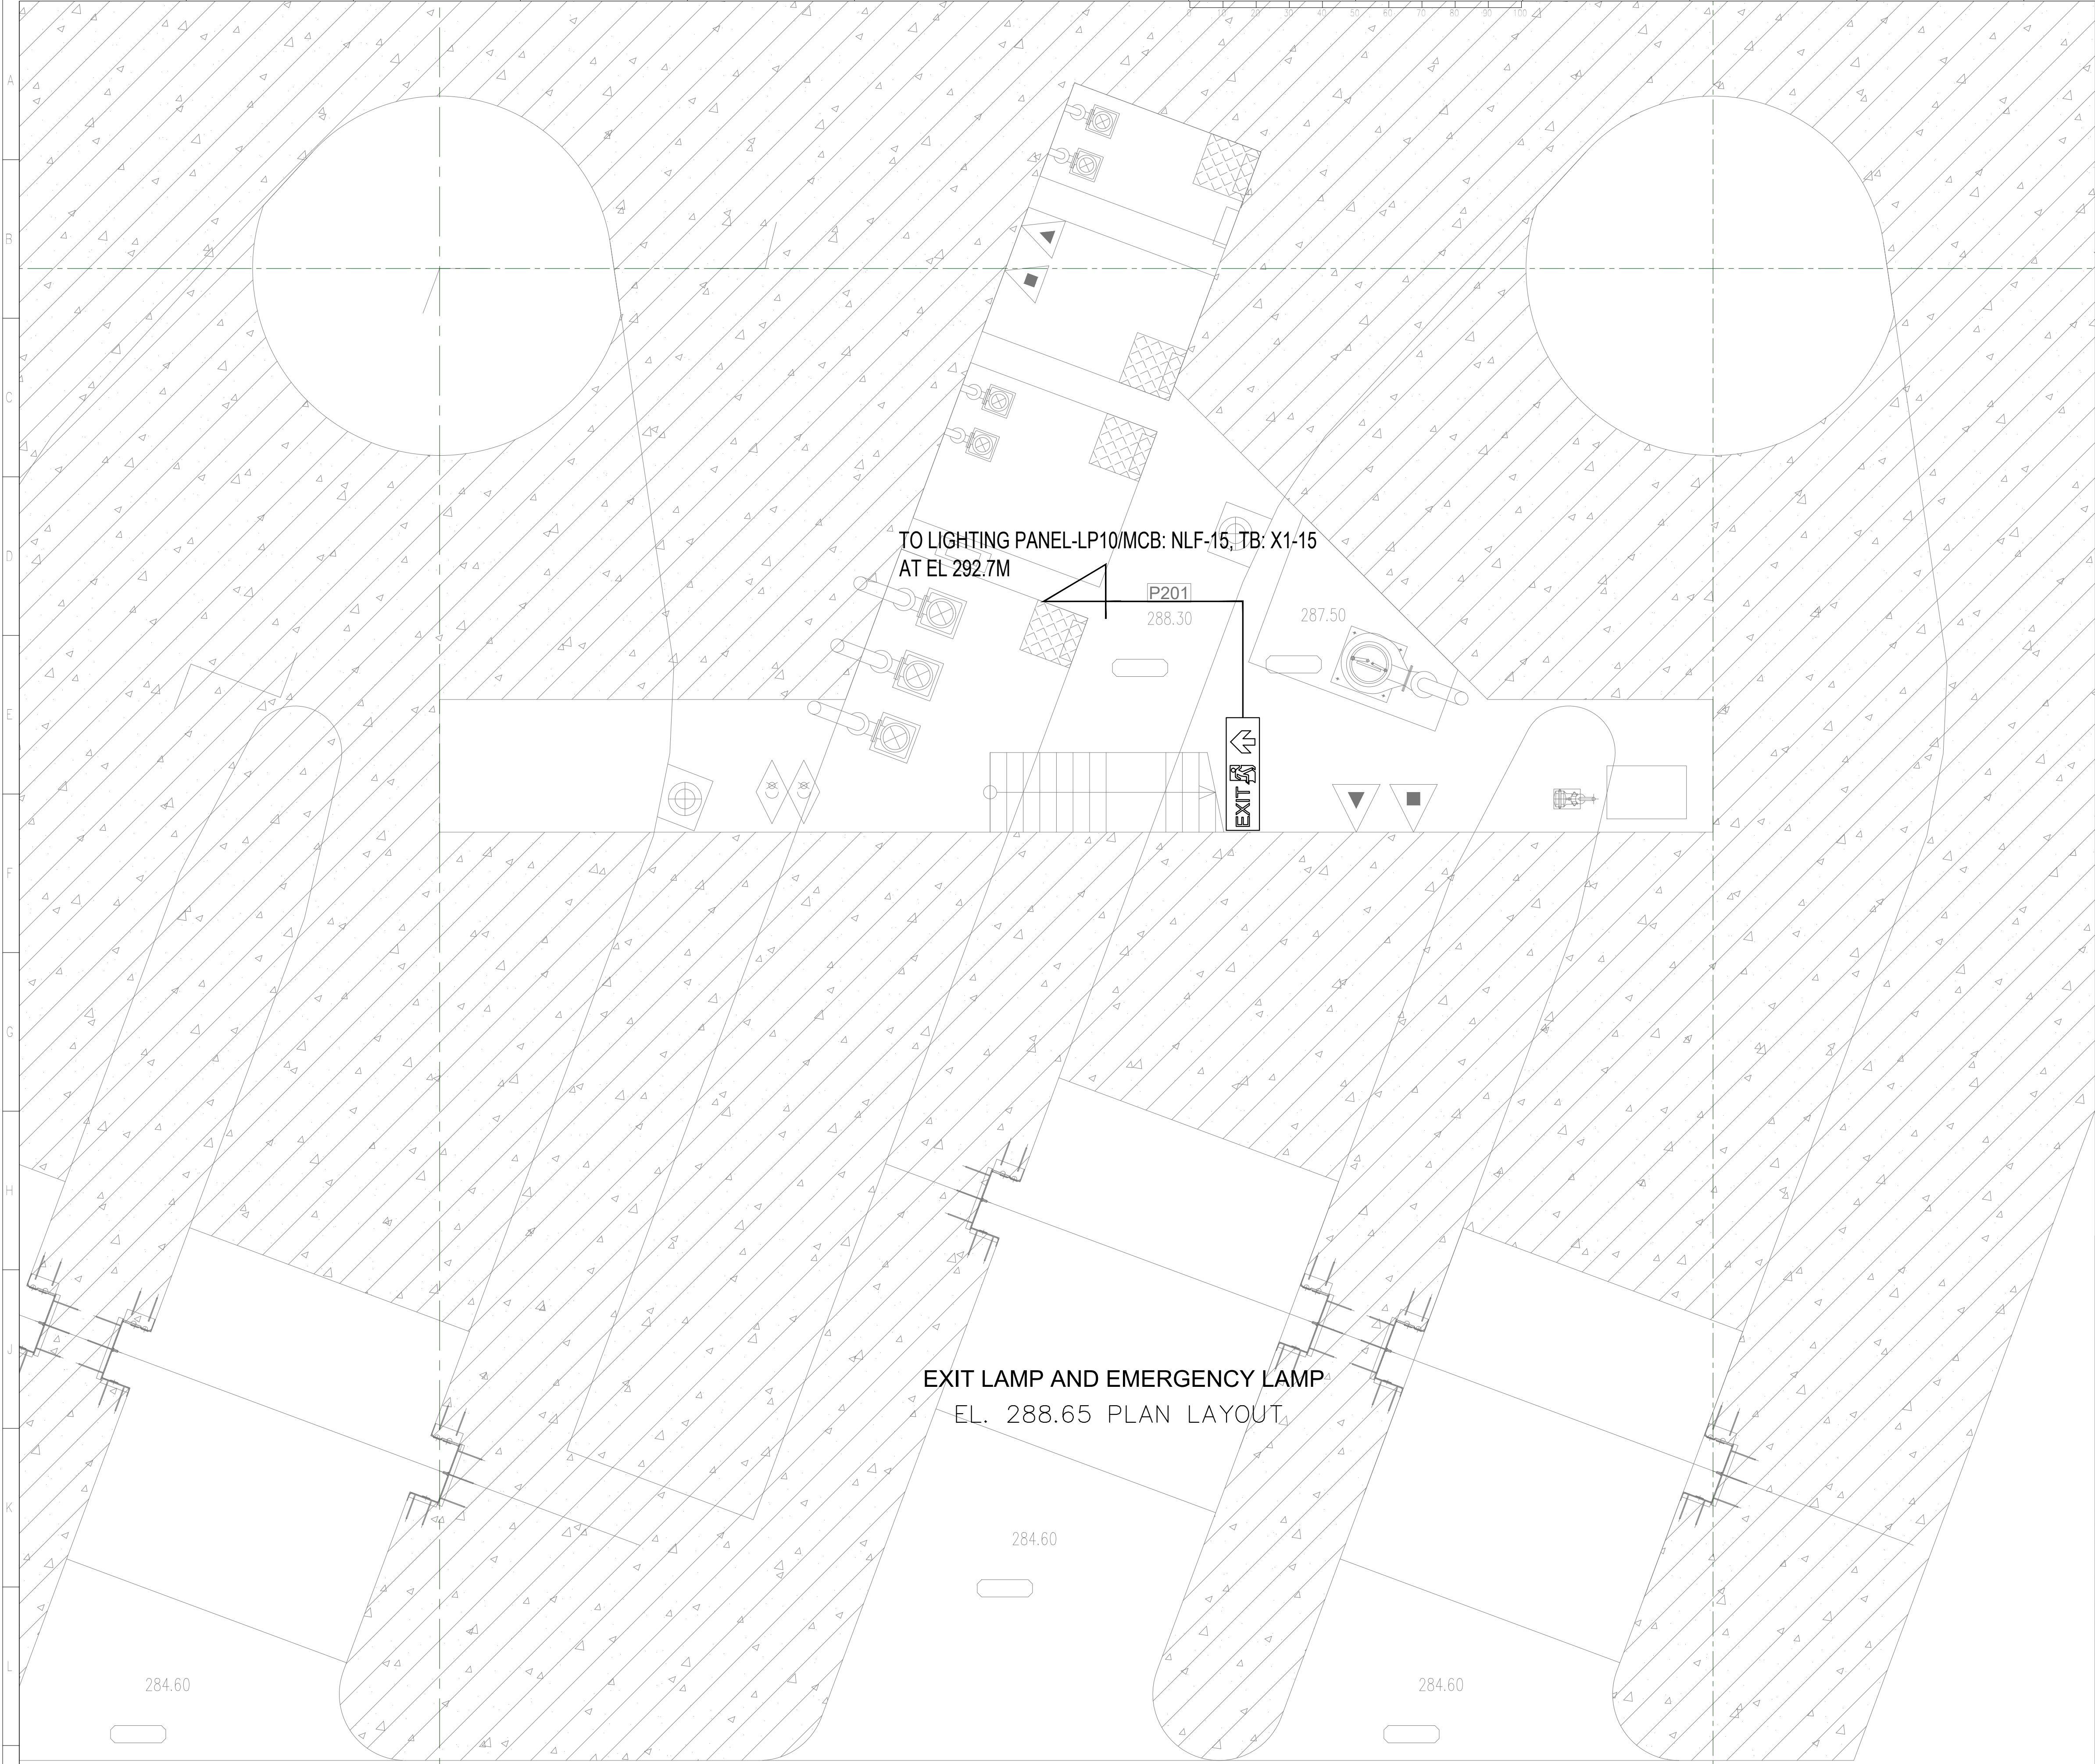

LEGEND:--				
NO.	SYMBOL	DESCRIPTION	Q'ty	REMARK
01.		POWER SUPPLY FOR LIGHTING SYSTEM	-	BY AH
02.		FIRE EXIT TO UPSTAIRS	1	
03.		FIRE EXIT TO RIGHT	-	
04.		FIRE EXIT TO LEFT	-	
05.		FIRE EXIT	-	

PURCHASER :
POWER PROJECTS MANAGEMENT BOARD NO. 2 - BRANCH OF VIETNAM ELECTRICITY EVNPMB2)

ANDRITZ HYDRO GmbH & 3 C INCORPORATION

PROJECT :

ITALY HYDRO POWER PLANT EXTENSION (2X180MW)
PACKAGE- NO.40 TB-01 (VIETNAM)

	AS-BUILT DRAWINGS						
B	REVISED AS PER CLIENT COMMENTS VIDE LETTER NO. 0709	22.Jan.24	N.V.T	D.V.L	LD		
A	INITIAL SUBMISSION	27.Nov.23	N.V.T	D.V.L	LD		
Index	Änderung Modification	Datum Date	Bearbeitet Prepared by	Geprüft Checked	Geprüft Checked	Genehmigt Approved	
Stückliste/Partslist			WA Nr.				
Abmess./Dimension			Klassen Nr.				
Gruppe/Group			Type				
			Maßstab/Scale				
			Gewicht/Weight		Material		
HAY	Datum/Date	Name	Kunde/Client	POWER PROJECTS MANAGEMENT BOARD NO. 2 (DPMB2)		Schutzvermerk	
Gez./Drawn	24.12.2022	NK	Anlage/Plant	ITALY HYDRO POWER PLANT EXTENSION		ISO 15016 beachten	
Gepr./Checked	24.12.2022	JCP	Projekt/Project	N° 24/IALYMR/2022/HB-A02-AH-3C		Refer to protection notice ISO 15016	
Gepr./Checked	24.12.2022	BRS	Vertr./Contract	N° 24/IALYMR/2022/HB-A02-AH-3C		Ähnl./Similar	
Genehm./Appr.	24.12.2022	JCP	File	Interne N°/Internal N°		Ers./Replace	
			XXXX		=		
			XXXX		+		
			Zeichnungs N°/Drawing N°		Index		
			ITALY-P40-AH-300-LAY-SGA-DG-1931-DI		BL./Sht. 31		
					von/of 31		